

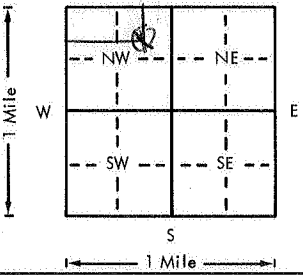
USE TYPEWRITER OR BALL  
POINT PEN-PRESS FIRMLY,  
PRINT CLEARLY.

WATER WELL RECORD  
KSA 82a-1201-1215

Kansas Department of Health and  
Environment-Division of Environment  
(Water well Contractors)  
Topeka, Kansas 66620

Reneker #1

CWW Inv. # 12121

1. Location of well:		County <b>Kearney</b>	Fraction <b>1/4C NE1/4NW 1/4</b>	Section number <b>4</b>	Township number <b>T 21 S</b>	Range number <b>R 38 E/W</b>
2. Distance and direction from nearest town or city: <b>Lakin, 13 West 3/4 North</b> Street address of well location if in city:			3. Owner of well: <b>Sage Drilling Company</b> R.R. or street: <b>500 Bitting Bldg.</b> City, state, zip code: <b>Wichita, Kansas 67202</b>			
4. Locate with "X" in section below: 			6. Bore hole dia. <b>9</b> in. Completion date <b>3-8-76</b> Well depth <b>180</b> ft.			
5. Type and color of material			7. <input type="checkbox"/> Cable tool <input checked="" type="checkbox"/> Rotary <input type="checkbox"/> Driven <input type="checkbox"/> Dug <input type="checkbox"/> Hollow rod <input type="checkbox"/> Jetted <input type="checkbox"/> Bored <input type="checkbox"/> Reverse rotary			
			8. Use: <input type="checkbox"/> Domestic <input type="checkbox"/> Public supply <input type="checkbox"/> Industry <input type="checkbox"/> Irrigation <input type="checkbox"/> Air conditioning <input type="checkbox"/> Stock <input type="checkbox"/> Lawn <input checked="" type="checkbox"/> Oil field water <input type="checkbox"/> Other			
			9. Casing: Material <input type="checkbox"/> Height Above or below Threaded <input type="checkbox"/> Welded <input type="checkbox"/> Surface <b>2/78</b> in. RMP <input type="checkbox"/> PVC <input checked="" type="checkbox"/> Weight <b>8.282</b> lbs./ft. Dia. <b>5</b> in. to <b>110</b> ft. depth Wall Thickness: inches or Dia. <input type="checkbox"/> in. to <input type="checkbox"/> ft. depth gage No. <b>.265</b>			
			10. Screen: Manufacturer's name <b>sawed perf.</b> Type <b>PVC</b> Dia. <b>5"</b> Slot/gauze <b>.030</b> Length <b>70</b> Set between <b>106</b> ft. and <b>176</b> ft. Gravel pack? <b>yes</b> Size range of material <b>1/8 to 3/16</b>			
			11. Static water level: <b>126</b> ft. below land surface Date <b>3-8-76</b> 12. Pumping level below land surfaces: <input type="checkbox"/> ft. after <input type="checkbox"/> hrs. pumping <input type="checkbox"/> g.p.m. <input type="checkbox"/> ft. after <input type="checkbox"/> hrs. pumping <input type="checkbox"/> g.p.m. Estimated maximum yield <b>30</b> g.p.m.			
13. Water sample submitted: <input type="checkbox"/> Yes <input checked="" type="checkbox"/> No Date			14. Well head completion: <input type="checkbox"/> Pitless adapter <b>28</b> Inches above grade			
15. Well grouted? <b>yes</b> With: <input checked="" type="checkbox"/> Neat cement <input type="checkbox"/> Bentonite <input type="checkbox"/> Concrete Depth: From <b>0</b> ft. to <b>10</b> ft.			16. Nearest source of possible contamination: ft. <b>100</b> Direction <b>NW</b> Type <b>oil well</b> Well disinfected upon completion? <input checked="" type="checkbox"/> Yes <input type="checkbox"/> No			
17. Pump: <input checked="" type="checkbox"/> Not installed Manufacturer's name Model number <input type="checkbox"/> HP <input type="checkbox"/> Volts Length of drop pipe <input type="checkbox"/> ft. capacity <input type="checkbox"/> g.p.m. Type: <input type="checkbox"/> Submersible <input type="checkbox"/> Turbine <input type="checkbox"/> Jet <input type="checkbox"/> Reciprocating <input type="checkbox"/> Centrifugal <input type="checkbox"/> Other			20. Water well contractor's certification: This well was drilled under my jurisdiction and this report is true to the best of my knowledge and belief. <b>Carlile Water Well 118</b> Business name <b>Box 275, Liberal, Ks.</b> License No. Address <b>Edward E. Means</b> Date <b>3-17</b> Signed <b>Edward E. Means</b> Authorized representative			
18. Elevation:		19. Remarks:		20. Water well contractor's certification:		
Topography: <input type="checkbox"/> Hill <input type="checkbox"/> Slope <input checked="" type="checkbox"/> Upland <input type="checkbox"/> Valley		(Use a second sheet if needed)				

Forward the white, blue and pink copies to the Department of Health and Environment

Form WWC-5