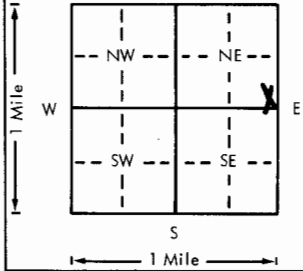


USE TYPEWRITER OR BALL  
POINT PEN-PRESS FIRMLY,  
PRINT CLEARLY.

WATER WELL RECORD  
KSA 82a-1201-1215

Kansas Department of Health and  
Environment-Division of Environment  
(Water well Contractors)  
Topeka, Kansas 66620

1. Location of well:	County <b>McPherson</b>	Fraction <b>SE 1/4 SE 1/4 NE 1/4</b>	Section number <b>3</b>	Township number <b>T 21 S</b>	Range number <b>R 4W E/W</b>	
2. Distance and direction from nearest town or city: <b>2 miles East and 1 1/2 miles North of Inman,</b> Street address of well location if in city: <b>Kansas</b>			3. Owner of well: <b>Lynn Postier</b> R.R. or street: <b>Inman, Kansas</b> City, state, zip code:			
4. Locate with "X" in section below: <div style="text-align: center;">N 1 Mile W  E S 1 Mile</div>			Sketch map:			
5. Type and color of material			From	To		
			<b>Topsoil</b>	<b>0</b>	<b>2</b>	
			<b>Clay</b>	<b>2</b>	<b>68</b>	
			<b>Medium to Coarse sand &amp; gravel with some clay</b>	<b>68</b>	<b>95</b>	
			<b>Clay</b>	<b>95</b>	<b>104</b>	
			<b>Medium to Coarse sand and gravel</b>	<b>104</b>	<b>119</b>	
			<b>Blue shale</b>	<b>119</b>	<b>120</b>	
6. Bore hole dia. <b>30</b> in. Completion date <b>12-16-78</b> Well depth <b>120</b> ft.			7. <input type="checkbox"/> Cable tool <input type="checkbox"/> Rotary <input type="checkbox"/> Driven <input type="checkbox"/> Dug <input type="checkbox"/> Hollow rod <input type="checkbox"/> Jetted <input type="checkbox"/> Bored <input checked="" type="checkbox"/> Reverse rotary			
8. Use: <input type="checkbox"/> Domestic <input type="checkbox"/> Public supply <input type="checkbox"/> Industry <input checked="" type="checkbox"/> Irrigation <input type="checkbox"/> Air conditioning <input type="checkbox"/> Stock <input type="checkbox"/> Lawn <input type="checkbox"/> Oil field water <input type="checkbox"/> Other			9. Casing: <b>Transite</b> Height: Above or below <b>114</b> See #19 <input checked="" type="checkbox"/> Welded <input type="checkbox"/> Surface <b>12</b> in. RMP <input type="checkbox"/> PVC <input type="checkbox"/> Weight <b>37</b> lbs./ft. Dia. <b>16</b> in. to <b>120</b> ft. depth Wall thickness: inches or Dia. <b>3/4</b> in. to <b>120</b> ft. depth gage No. <b>3/4</b>			
10. Screen: Manufacturer's name <b>Johnson</b> Type <b>irrigator</b> Dia. <b>16"</b> Slot <b>1/16"</b> .100 Length <b>41'</b> Set between <b>69</b> ft. and <b>95</b> ft. <b>104</b> ft. and <b>119</b> ft. Gravel pack? <b>yes</b> Size range of material <b>1/4-1/8"</b>			11. Static water level: <b>26</b> ft. below land surface Date <b>12-20-78</b> mo./day/yr.			
12. Pumping level below land surfaces: ____ ft. after ____ hrs. pumping ____ g.p.m. ____ ft. after ____ hrs. pumping ____ g.p.m. Estimated maximum yield ____ g.p.m.			13. Water sample submitted: ____ mo./day/yr. <input type="checkbox"/> Yes <input checked="" type="checkbox"/> No Date ____			
14. Well head completion: <input type="checkbox"/> Pitless adapter <b>24</b> inches above grade			15. Well grouted? <b>yes 1-2 fine sand mix</b> With: <input type="checkbox"/> Neat cement <input type="checkbox"/> Bentonite <input checked="" type="checkbox"/> Concrete Depth: From <b>0</b> ft. to <b>12</b> ft.			
16. Nearest source of possible contamination: ft. ____ Direction ____ Type <b>None</b> Well disinfected upon completion? <input checked="" type="checkbox"/> Yes <input type="checkbox"/> No			17. Pump: <input checked="" type="checkbox"/> Not installed Manufacturer's name ____ Model number ____ HP ____ Volts ____ Length of drop pipe ____ ft. capacity ____ g.p.m. Type: <input type="checkbox"/> Submersible <input type="checkbox"/> Turbine <input type="checkbox"/> Jet <input type="checkbox"/> Reciprocating <input type="checkbox"/> Centrifugal <input type="checkbox"/> Other			
18. Elevation:			19. Remarks:			
Topography: <input type="checkbox"/> Hill <input type="checkbox"/> Slope <input type="checkbox"/> Upland <input type="checkbox"/> Valley			<p style="text-align: center;"><b>Flat ground</b> <b>From #19 above: Banded But Joint</b> <b>No apparent source for contamination.</b></p>			
			20. Water well contractor's certification: This well was drilled under my jurisdiction and this report is true to the best of my knowledge and belief. <b>Harp Well &amp; Pump</b> <b>236</b> Business name License No. Address <b>Wichita, Kansas</b> <b>67209</b> Signed <b>M. Arnold</b> Date <b>1-15-79</b> Authorized representative			

21-40-3  
 T  
 R  
 Sec  
 1/4  
 1/4  
 1/4  
 SE  
 SE  
 NE