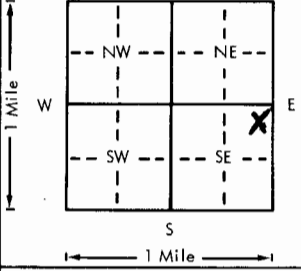


USE TYPEWRITER OR BALL
POINT PEN-PRESS FIRMLY,
PRINT CLEARLY.

WATER WELL RECORD
KSA 82a-1201-1215

Kansas Department of Health and
Environment-Division of Environment
(Water well Contractors)
Topeka, Kansas 66620

1. Location of well:	County Mapherson	Fraction Ne 1/4 Ne 1/4 Se 1/4	Section number 7	Township number T 21 S	Range number R 4 E W
2. Distance and direction from nearest town or city:	1 1/2 W Inman		3. Owner of well: James Snyder R.R. or street: City, state, zip code: Inman KS		
4. Locate with "X" in section below:	Sketch map: 		6. Bore hole dia 8 1/2 in. Completion date 10-27-78 Well depth 87 ft.		
5. Type and color of material	From	To	7. <input checked="" type="checkbox"/> Cable tool <input type="checkbox"/> Rotary <input type="checkbox"/> Driven <input type="checkbox"/> Dug <input type="checkbox"/> Hollow rod <input type="checkbox"/> Jetted <input type="checkbox"/> Bored <input type="checkbox"/> Reverse rotary		
Top Soil	0	2	8. Use: <input checked="" type="checkbox"/> Domestic <input type="checkbox"/> Public supply <input type="checkbox"/> Industry <input checked="" type="checkbox"/> Irrigation <input type="checkbox"/> Air conditioning <input type="checkbox"/> Stock <input type="checkbox"/> Lawn <input type="checkbox"/> Oil field water <input type="checkbox"/> Other		
Yellow + Red clay	2	45	9. Casing: Material Styrene Weight: 94 lbs./ft. Threaded <input type="checkbox"/> Welded <input type="checkbox"/> Surface <input type="checkbox"/> in. RMP <input type="checkbox"/> PVC <input type="checkbox"/> Weight <input type="checkbox"/> lbs./ft. Dia. 3 in. to 27 ft. depth Wall Thickness: inches or Dia. <input type="checkbox"/> in. to <input type="checkbox"/> ft. depth gage 200 wall		
Some water	45	46	10. Screen: Manufacturer's name Stess + Howell Type Styrene Dia. 5 1/2 Slot/gauze 40 Length 20 Set between 40 ft. and 30 ft. 70 ft. and 80 ft.		
Red Shale	46	78	Gravel pack? <input checked="" type="checkbox"/> Size range of material 4-2		
Water	78	80	11. Static water level: 37 ft. below land surface Date 10-27-78 mo./day/yr.		
Red + Blue Shale	80	87	12. Pumping level below land surfaces: ____ ft. after ____ hrs. pumping ____ g.p.m. ____ ft. after ____ hrs. pumping ____ g.p.m. Estimated maximum yield ____ g.p.m.		
			13. Water sample submitted: ____ mo./day/yr. <input type="checkbox"/> Yes <input checked="" type="checkbox"/> No Date ____		
			14. Well head completion: In Grage <input checked="" type="checkbox"/> Pitless adapter 12 Inches above grade		
			15. Well grouted? <input checked="" type="checkbox"/> With: <input checked="" type="checkbox"/> Neat cement <input type="checkbox"/> Bentonite <input type="checkbox"/> Concrete Depth: From 3 ft. to 13 ft.		
			16. Nearest source of possible contamination: Sewer ft. 100 Direction S Type Line Well disinfected upon completion? <input checked="" type="checkbox"/> Yes <input type="checkbox"/> No		
			17. Pump: <input checked="" type="checkbox"/> Not installed Manufacturer's name ____ Model number ____ HP ____ Volts ____ Length of drop pipe ____ ft. capacity ____ g.p.m. Type: <input type="checkbox"/> Submersible <input type="checkbox"/> Turbine <input type="checkbox"/> Jet <input type="checkbox"/> Reciprocating <input type="checkbox"/> Centrifugal <input type="checkbox"/> Other		
18. Elevation:	19. Remarks:		20. Water well contractor's certification: This well was drilled under my jurisdiction and this report is true to the best of my knowledge and belief. Backhus Drgl 180 Business name Tampa KS License No. ____ Address Tampa KS Signed Paul Backhus Date 10-27-78 Authorized representative		

Forward the white, blue and pink copies to the Department of Health and Environment

Form WWC-5