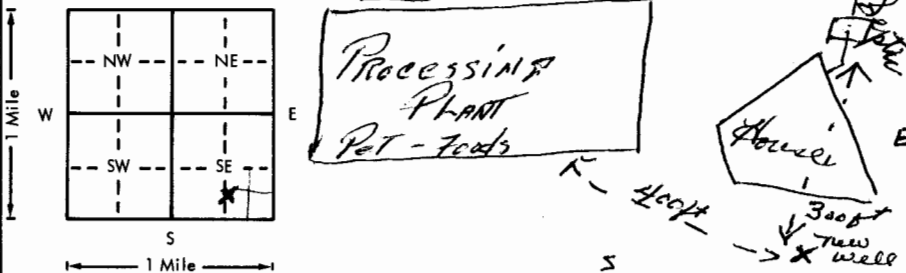


USE TYPEWRITER OR BALL  
POINT PEN-PRESS FIRMLY,  
PRINT CLEARLY.

WATER WELL RECORD  
KSA 82a-1201-1215

Kansas Department of Health and  
Environment-Division of Environment  
(Water well Contractors)  
Topeka, Kansas 66620

1. Location of well: County <u>McPherson</u> Fraction <u>W 1/2 SE 1/4 SE 1/4</u> Section number <u>26</u> Township number <u>T 21 S</u> Range number <u>R 4 E</u> (NW)			
2. Distance and direction from nearest town or city: <u>3 S - 2 3/4 E</u> Street address of well location if in city: <u>Inman, Kans.</u>		3. Owner of well: <u>Hoertgen Processing, Inc.</u> R.R. or street: <u>R.R. To Labor, Florida</u> City, state, zip code: <u>Inman Kans. 67546</u>	
4. Locate with "X" in section below: <u>Lagoon</u> Sketch map: <u>N</u> 		6. Bore hole dia. <u>8"</u> in. Completion date <u>10-7-76</u> Well depth <u>140</u> ft.	
5. Type and color of material		7. <input type="checkbox"/> Cable tool <input checked="" type="checkbox"/> Rotary <input type="checkbox"/> Driven <input type="checkbox"/> Dug <input type="checkbox"/> Hollow rod <input type="checkbox"/> Jetted <input type="checkbox"/> Bored <input type="checkbox"/> Reverse rotary	
Top Soil		8. Use: <input checked="" type="checkbox"/> Domestic <input type="checkbox"/> Public supply <input checked="" type="checkbox"/> Industry <input type="checkbox"/> Irrigation <input type="checkbox"/> Air conditioning <input type="checkbox"/> Stock <input type="checkbox"/> Lawn <input type="checkbox"/> Oil field water <input type="checkbox"/> Other	
Dark clays		9. Casing: Material <u>PLTS</u> Height: (Above or below) Threaded <input type="checkbox"/> Welded <input checked="" type="checkbox"/> Surface <u>18"</u> in. RMP <input type="checkbox"/> PVC <input checked="" type="checkbox"/> Weight <u>      </u> lbs./ft. Dia. <u>5</u> in. to <u>136</u> ft. depth Wall Thickness: inches or Dia. <u>      </u> in. to <u>      </u> ft. depth gage No. <u>44"</u>	
Buff & gray clays sandy		10. Screen: Manufacturer's name <u>Artisan Lead</u> <u>sawed slot</u> Type <u>P.V.C.</u> Dia. <u>5"</u> Slot/gauze <u>1/16</u> Length <u>10'</u> Set between <u>130'</u> ft. and <u>140'</u> ft. <u>      </u> ft. and <u>      </u> ft. Gravel pack? <input checked="" type="checkbox"/> Size range of material <u>14-18"</u>	
Gray clays & lenses of fine sands		11. Static water level: <u>28</u> ft. below land surface Date <u>10-7-76</u> mo./day/yr.	
Blue clays		12. Pumping level below land surfaces: <u>32</u> ft. after <u>2</u> hrs. pumping <u>18</u> g.p.m. <u>      </u> ft. after <u>      </u> hrs. pumping <u>      </u> g.p.m. Estimated maximum yield <u>100</u> g.p.m.	
Hard Blue clays		13. Water sample submitted: <u>      </u> mo./day/yr. <input type="checkbox"/> Yes <input checked="" type="checkbox"/> No Date <u>      </u>	
Buff clays		14. Well head completion: <u>Pitless adapter</u> <u>12</u> inches above grade	
Lime rock & white clays		15. Well grouted? <u>yes</u> With: <input checked="" type="checkbox"/> Neat cement <input type="checkbox"/> Bentonite <input type="checkbox"/> Concrete Depth: From <u>0</u> ft. to <u>15</u> ft.	
Med sands & gravels - coarse		16. Nearest source of possible contamination: <u>300</u> ft. Direction <u>N.E.</u> Type <u>Septic</u> Well disinfected upon completion? <input checked="" type="checkbox"/> Yes <input type="checkbox"/> No	
Fine to med sands & silt & shales		17. Pump: <u>Not installed</u> Manufacturer's name <u>Truon</u> Model number <u>441024</u> HP <u>1</u> Volts <u>230</u> Length of drop pipe <u>70</u> ft. capacity <u>18</u> g.p.m. Type: <input checked="" type="checkbox"/> Submersible <input type="checkbox"/> Turbine <input type="checkbox"/> Jet <input type="checkbox"/> Reciprocating <input type="checkbox"/> Centrifugal <input type="checkbox"/> Other	
Very hard Buff clays		20. Water well contractor's certification: This well was drilled under my jurisdiction and this report is true to the best of my knowledge and belief. <u>Peterson Bros Inc</u> 138 Business name License No. Address <u>Leedsburg Kans</u> Signed <u>Uncle Peterson</u> Date <u>10-7-76</u> Authorized representative	
18. Elevation:		19. Remarks: <u>Mr. Foyce will have 5 ft. slab poured for pump house. We will install pump in 10 days.</u> <u>Chas. Peterson</u>	

Forward the white, blue and pink copies to the Department of Health and Environment

Form WWC-5