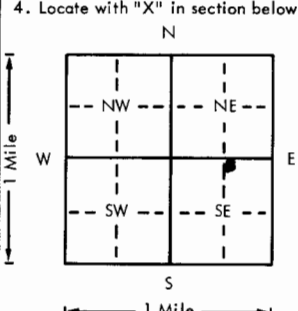


USE TYPEWRITER OR BALL
POINT PEN-PRESS FIRMLY,
PRINT CLEARLY.

WATER WELL RECORD
KSA 82a-1201-1215

Kansas Department of Health and
Environment-Division of Environment
(Water well Contractors)
Topeka, Kansas 66620

| | | | | | |
|---|--|---|---|----------------------------------|------------------------------|
| 1. Location of well: | County <u>McPherson</u> | Fraction <u>NW 1/4 NE 1/4 SE 1/4</u> | Section number <u>35</u> | Township number <u>T 21 S</u> | Range number <u>R 4 E</u> |
| 2. Distance and direction from nearest town or city: Street address of well location if in city: | <u>3.50 Imman</u> <u>3 East 1/2 So. 1/4</u> <u>West in field</u> | | 3. Owner of well: R.R. or street: City, state, zip code: <u>John Goertzen</u> <u>Inman, Kansas 67546</u> | | |
| 4. Locate with "X" in section below: N W E S 1 Mile |  | | 6. Bore hole dia. <u>26</u> in. Completion date <u>5/4/78</u> Well depth <u>162</u> ft. | | |
| 5. Type and color of material | From | To | 7. <input type="checkbox"/> Cable tool <input type="checkbox"/> Rotary <input type="checkbox"/> Driven <input type="checkbox"/> Dug <input type="checkbox"/> Hollow rod <input type="checkbox"/> Jetted <input type="checkbox"/> Bored <input checked="" type="checkbox"/> Reverse rotary | | |
| Gray clay | 0 | 10 | 8. Use: <input type="checkbox"/> Domestic <input type="checkbox"/> Public supply <input type="checkbox"/> Industry <input checked="" type="checkbox"/> Irrigation <input type="checkbox"/> Air conditioning <input type="checkbox"/> Stock <input type="checkbox"/> Lawn <input type="checkbox"/> Oil field water <input type="checkbox"/> Other | | |
| Brown clay | 10 | 20 | 9. Casing: Material <u>Transite</u> Height: Above or below Threaded <input type="checkbox"/> Welded <input type="checkbox"/> Surface <u>12</u> in. RMP <input type="checkbox"/> PVC <input type="checkbox"/> Weight <u>30</u> lbs./ft. Dia. <u>16</u> in. to <u>110</u> ft. depth Wall Thickness: inches of Dia. <u>16</u> in. to <u>110</u> ft. depth gage No. <u>3/26 3/4</u> | | |
| Gray clay with fine sand | 20 | 35 | 10. Screen: Manufacturer's name <u>Johnson</u> Type <u>sawed</u> Dia. <u>16</u> Slot/gauze <u>3/16</u> Length <u>52</u> Set between <u>110</u> ft. and <u>162</u> ft. ft. and <u>162</u> ft. Gravel pack? <u>yes</u> Size range of material <u>1/8-1/4</u> | | |
| Gray clay | 35 | 45 | 11. Static water level: <u>25</u> ft. below land surface Date <u>5/4/78</u> mo./day/yr. | | |
| Clay with fine sand | 45 | 50 | 12. Pumping level below land surfaces: <u>41</u> ft. after <u>1</u> hrs. pumping <u>800</u> g.p.m. <u>56</u> ft. after <u>2</u> hrs. pumping <u>1400</u> g.p.m. Estimated maximum yield <u>1700</u> g.p.m. | | |
| Gray clay | 50 | 60 | 13. Water sample submitted: <u>Yes</u> <input checked="" type="checkbox"/> No <input type="checkbox"/> Date <u>5/4/78</u> mo./day/yr. | | |
| Med. sand | 60 | 70 | 14. Well head completion: <u>Pitless adapter</u> <u>12</u> inches above grade | | |
| Sand, little clay | 70 | 75 | 15. Well grouted? <u>yes</u> With: <input type="checkbox"/> Neat cement <input type="checkbox"/> Bentonite <input checked="" type="checkbox"/> Concrete Depth: From <u>0</u> ft. to <u>10</u> ft. | | |
| Blue gray clay | 75 | 85 | 16. Nearest source of possible contamination: ft. <u>none</u> Direction <u>none</u> Type <u>none</u> Well disinfected upon completion? <u>Yes</u> <input checked="" type="checkbox"/> No <input type="checkbox"/> | | |
| Light brown clay | 85 | 110 | 17. Pump: <u>Not installed</u> Manufacturer's name <u>Western Roller (Land)</u> Model number <u>4 stage 10CH60</u> Volts <u>700</u> Length of drop pipe <u>30</u> ft. capacity <u>700</u> g.p.m. Type: <input type="checkbox"/> Submersible <input checked="" type="checkbox"/> Turbine <input type="checkbox"/> Jet <input type="checkbox"/> Reciprocating <input type="checkbox"/> Centrifugal <input type="checkbox"/> Other | | |
| Clay, little sand | 110 | 115 | 20. Water well contractor's certification: This well was drilled under my jurisdiction and this report is true to the best of my knowledge and belief. <u>Darling Drilling Co.</u> <u>189</u> Business name <u>1211 W. 4th, Hutchinson, Kan.</u> License No. <u>189</u> Address <u>Donald Dasher</u> Date <u>6-1-79</u> Signed <u>Donald Dasher</u> Authorized representative | | |
| Med. gravel, little clay | 115 | 120 | | | |
| Med. gravel | 120 | 130 | | | |
| Med. gravel, little clay | 130 | 135 | | | |
| Med. gravel | 135 | 155 | | | |
| (Use a second sheet if needed) Med. gravel | 155 | 165 | | | |
| 18. Elevation: | 19. Remarks: <u>little clay</u> <u>165</u> | | | | |
| Topography: <input type="checkbox"/> Hill <input type="checkbox"/> Slope <input checked="" type="checkbox"/> Upland <input type="checkbox"/> Valley | | | | | |

Forward the white, blue and pink copies to the Department of Health and Environment

Form WWC-5