

MW-19M

WATER WELL RECORD


Form WWC-5

Division of Water Resources App. No.

1 LOCATION OF WATER WELL: County: McPherson Fraction 1/4 SW 1/4 SW 1/4 NW 1/4 Section Number 16 Township No. T 21 S Range Number R 4 E XW

Street/Rural Address of Well Location; if unknown, distance & direction from nearest town or intersection: Unified school lawn, next to storage building Global Positioning System (GPS) information: Latitude: 38.22602 Longitude: 97.77541

2 WATER WELL OWNER: USDA - Steve Gilmore RR#, Street Address, Box #: Stop 0513 Room 4714-S City, State, ZIP Code: 1400 Independence Ave, SW Washington, DC. 20250-0513

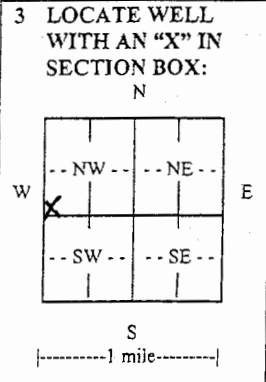

3 LOCATE WELL WITH AN 'X' IN SECTION BOX: N E W S 4 DEPTH OF COMPLETED WELL 95 ft. Depth(s) Groundwater Encountered (1) 32.65 ft. (2) ft. (3) ft. WELL'S STATIC WATER LEVEL 32.65 ft. below land surface measured on mo/day/yr 9/15/11

5 TYPE OF CASING USED: Steel X PVC Other CASING JOINTS: Glued Clamped Welded X Threaded Casing diameter 2 in. to 8.5 ft. Diameter in. to in. to ft. Casing height above land surface 2.5 in. Weight 93 lbs./ft. Wall thickness or gauge No. Sch. 80

6 GROUT MATERIAL: Neat cement Cement grout X Bentonite Other Grout Intervals: From 2.5 ft. to 83 ft. From ft. to ft. From ft. to ft. What is the nearest source of possible contamination: Septic tank Lateral lines Pit privy Livestock pens Insecticide storage Other (specify below)

Table with columns: FROM, TO, LITHOLOGIC LOG, FROM, TO, LITHO. LOG (cont.) or PLUGGING INTERVALS. Row 1: 0, 30, Clay, 30, 100, Weathered Shale

7 CONTRACTOR'S OR LANDOWNER'S CERTIFICATION: This water well was X constructed, reconstructed, or plugged under my jurisdiction and was completed on (mo/day/year) 8/31/11 and this record is true to the best of my knowledge and belief.

INSTRUCTIONS: Use typewriter or ball point pen. PLEASE PRESS FIRMLY and PRINT clearly. Please fill in blanks and check the correct answers. Send three copies (white, blue, pink) to Kansas Department of Health and Environment, Bureau of Water, Geology Section, 1000 SW Jackson St., Suite 420, Topeka, Kansas 66612-1367.