

# WATER WELL PLUGGING RECORD Form WWC-5P

KSA 82a-1212

ID NO.

31838

<b>1 LOCATION OF WATER WELL:</b> County: McPherson	Fraction ¼ CS ¼ SE ¼ SE ¼	Section Number 26	Township Number T 21 S	Range Number 4 <input type="checkbox"/> E <input checked="" type="checkbox"/> W
---	------------------------------	----------------------	---------------------------	--

Street/Rural Address of Well Location; if unknown, distance & direction from nearest town or intersection: If at owner's address, check here ☐ Approximately 2.5 miles south and

2.25 miles east of Inman, KS

## Global Positioning Systems (GPS) information:

Latitude: 38.18843 (in decimal degrees)

Longitude: -97.72245 (in decimal degrees)

Elevation:

Datum: ☐ WGS84, ☐ NAD83, ☒ NAD27

Collection Method:


☒ GPS unit (Make/Model: Garmin GPSmap 60CSx

☐ Digital Map/Photo, ☐ Topographic Map, ☐ Land Survey

Est. Accuracy: ☐ < 3 m, ☒ 3-5 m, ☐ 5-15 m, ☐ > 15 m

**2 WATER WELL OWNER:** John Gaedert  
RR#, St. Address, Box #: 7724 N Wheat State Rd  
City, State ZIP Code: Buhler, KS 67522

## 3 MARK WELL'S LOCATION WITH AN "X" IN SECTION BOX:

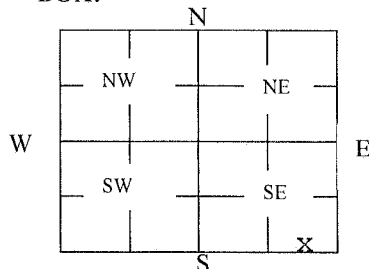

## 4 DEPTH OF WELL 184 ft.

WELL'S STATIC WATER LEVEL 45 ft.

WELL WAS USED AS:

☐ Domestic  
☒ Irrigation  
☐ Feedlot  
☐ Industrial

☐ Public Water Supply  
☐ Oil Field Water Supply  
☐ Domestic (Lawn & Garden)  
☐ Air Conditioning

☐ Dewatering  
☐ Monitoring  
☐ Injection Well  
☐ Other

Was a chemical/bacteriological sample submitted to Department? Yes ☐ No ☒

## 5 TYPE OF BLANK CASING USED:

☐ Steel  
☐ PVC

☐ RMP (SR)  
☐ ABS

☐ Wrought  
☐ Asbestos-Cement

☐ Fiberglass  
☒ Concrete Tile

☐ Other (Specify below)

Blank casing diameter 18 in. Was casing pulled? Yes ☐ No ☒ If yes, how much  
Casing height above or below land surface below 36 in.

## 6 GROUT PLUG MATERIAL: ☐ Neat cement ☒ Cement grout ☐ Bentonite ☐ Other

Grout Plug Intervals: From 45 ft. to 3 ft., From ft. to ft., From to ft.

What is the nearest source of possible contamination:

☐ Septic tank  
☐ Sewer lines  
☐ Watertight sewer lines  
☐ Lateral lines  
☐ Cess pool

☐ Seepage pit  
☐ Pit privy  
☐ Sewage lagoon  
☐ Feedyard  
☐ Livestock pens

☐ Fuel Storage  
☐ Fertilizer storage  
☐ Insecticide storage  
☐ Abandoned water well  
☐ Oil well/Gas well

☒ Other (specify below)  
Gas Line

Direction from well? Southwest

How many feet? Approximately 10 ft.

FROM	TO	PLUGGING MATERIALS	FROM	TO	PLUGGING MATERIALS
184	45	Clean, coarse sand			Well plugging witnessed by
45	3	Cement grout			D. Randolph, GMD2 staff on 4-16-13.
3	0	Topsoil			Topsoil backfilled over plugged
					well on 5-11-13

**7 CONTRACTOR'S OR LANDOWNER'S CERTIFICATION:** This water well was plugged under my jurisdiction and was completed on (mo/day/year) 5-11-2013 and this record is true to the best of my knowledge and belief. Kansas Water Well Contractor's License No. This Water Well Record was completed on (mo/day/year) 6-6-2013 under the business name of by (signature) 6-10-13

**INSTRUCTIONS:** Use typewriter or ballpoint pen. Please press firmly and print clearly. Please fill in blanks, underline or circle the correct answers. Send top three copies to Kansas Department of Health and Environment, Bureau of Water, Geology Section, 1000 SW Jackson St., Ste. 420, Topeka, Kansas 66612-1367. Telephone: 781-1111. One to Water Well Owner and retain one for your records. Visit us at <http://www.kdheks.gov/waterwell/index.html>.

JUN 13 2013

Check one:

☐ White Copy

☐ Blue Copy

☐ Pink Copy