

WATER WELL PLUGGING RECORD Form WWC-5P KSA 82a-1212 ID NO.


27413

1 LOCATION OF WATER WELL: County: McPherson Fraction: 1/4 1/4 NC 1/4 NE 1/4 Section Number: 13 Township Number: T 21 S Range Number: 4 E W

Street/Rural Address of Well Location; if unknown, distance & direction from nearest town or intersection: If at owner's address, check here approximately 3.25 miles east of
Inman, KS

2 WATER WELL OWNER: Virgil Unruh
RR#, St. Address, Box #: 139 13th Ave
City, State ZIP Code: Inman, KS 67546

Global Positioning Systems (GPS) information:
Latitude: 38.22831 (in decimal degrees)
Longitude: -97.70631 (in decimal degrees)
Elevation: _____
Datum: WGS84, NAD83, NAD27
Collection Method:
 GPS unit (Make/Model: Garmin GPSmap 60CSx)
 Digital Map/Photo, Topographic Map, Land Survey
Est. Accuracy: < 3 m, 3-5 m, 5-15 m, > 15 m

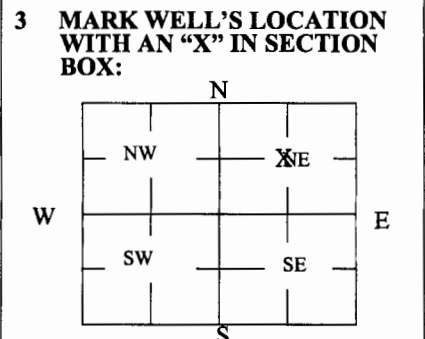

4 DEPTH OF WELL 225 ft.
WELL'S STATIC WATER LEVEL 33.65 ft.
WELL WAS USED AS:
 Domestic Public Water Supply Dewatering
 Irrigation Oil Field Water Supply Monitoring
 Feedlot Domestic (Lawn & Garden) Injection Well
 Industrial Air Conditioning Other _____
Was a chemical/bacteriological sample submitted to Department? Yes No

5 TYPE OF BLANK CASING USED:
 Steel RMP (SR) Wrought Fiberglass Other (Specify below)
 PVC ABS Asbestos-Cement Concrete Tile _____
Blank casing diameter 16 in. Was casing pulled? Yes No If yes, how much _____
Casing height above or below land surface below 84 in.

6 GROUT PLUG MATERIAL: Neat cement Cement grout Bentonite Other _____
Grout Plug Intervals: From 33.65 ft. to 7 ft., From _____ ft. to _____ ft., From _____ to _____ ft.
What is the nearest source of possible contamination:
 Septic tank Seepage pit Fuel Storage Other (specify below)
 Sewer lines Pit privy Fertilizer storage Wastewater Pond
 Watertight sewer lines Sewage lagoon Insecticide storage _____
 Lateral lines Feedyard Abandoned water well Direction from well? northeast
 Cess pool Livestock pens Oil well/Gas well How many feet? approximately 1200 ft

FROM	TO	PLUGGING MATERIALS	FROM	TO	PLUGGING MATERIALS
225	201	Formation sand (casing collapsed)			Well plugging witnessed by D. Randolph, GMD2 staff, on 4/10/2014 and 4/11/2014
201	33.65	Clean, course sand			
33.65	7	Cement grout			
7	0	Topsoil			

7 CONTRACTOR'S OR LANDOWNER'S CERTIFICATION: This water well was plugged under my jurisdiction and was completed on (mo/day/year) 4/11/2014 and this record is true to the best of my knowledge and belief. Kansas Water Well Contractor's License No. _____. This Water Well Record was completed on (mo/day/year) 4/29/2014 under the business name of _____ by (signature) Virgil Unruh

INSTRUCTIONS: Use typewriter or ballpoint pen. Please press firmly and print clearly. Please fill in blanks, underline or circle the correct answers. Send one copy to Kansas Department of Health and Environment, Bureau of Water, Geology and Hydrology, 1000 SW Jackson St., Ste. 420, Topeka, Kansas 66612-1367. Telephone: 785/296-5524. Send one to Water Well Owner and return one for your records. Visit us at <http://www.kdheks.gov/waterwell/index.html>.

RECEIVED
MAY 09 2014