


WATER WELL RECORD Form WWC-5 KSA 82a-1212

1 LOCATION OF WATER WELL: Fraction Section Number Township Number Range Number  
 COUNTY: HAMILTON NE 1/4 NE 1/4 NE 1/4 4 T 21 S R 41 W

Distance and direction from nearest town or city street address of well if located within city?  
 FROM SYRACUSE ON HIGHWAY 27 - 20 MILES NORTH & 3 WEST

2 WATER WELL OWNER: EDDY, VAN CHARLES Board of Agriculture, Division of Water Resources  
 RP#, St. Address, Box #: BOX 666 Application Number:  
 City, State, ZIP code: SYRACUSE, KS 67878-

3 LOCATE WELL'S LOCATION WITH AN "X" IN SECTION BOX: 4 DEPTH OF COMPLETED WELL 130 ELEVATION: 0  
 Depth(s) Groundwater Encountered 1. 0 ft. 2. 0 ft. 3. 0 ft.

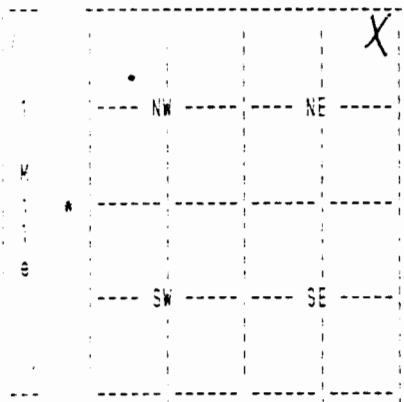

WELL'S STATIC WATER LEVEL 124 ft. below land surface measured on mo/day/yr 12/18/08  
 Pump test data: Well water was 0 ft. after 0 hours pumping 0 gpm

Estimated Yield 0 gpm: Well water was 0 ft. after 0 hours pumping 0 gpm

Bore Hole Diameter in. to 0 ft., and in. to 0 ft.

WELL WATER WAS: DOMESTIC

Was a chemical/bacteriological sample submitted to department? No ;  
 If yes, mo/day/yr sample was submitted Water well disinfected? Yes

5 TYPE OF BLANK CASING USED: tin CASING JOINTS:  
 Blank casing diameter 5 in. to 130 ft., Dia in. to 0 ft., Dia in. to 0 ft.  
 Casing height above land surface 0 in., weight 0 lbs/ft. Wall thickness or gauge No.

TYPE OF SCREEN OR PERFORATION MATERIAL:  
 SCREEN OR PERFORATION OPENINGS ARE:

SCREEN PERFORATED INTERVALS: From 0 ft. to 0 ft., From 0 ft. to 0 ft.  
 From 0 ft. to 0 ft., From 0 ft. to 0 ft.  
 GRAVEL PACK INTERVALS: From 0 ft. to 0 ft., From 0 ft. to 0 ft.  
 From 0 ft. to 0 ft., From 0 ft. to 0 ft.

6 GROUT MATERIAL BENTONITE  
 Grout Intervals: From 0 ft. to 0 ft., From 0 ft. to 0 ft., From 0 ft. to 0 ft.  
 What is the nearest source of possible contamination: NONE  
 Direction from well? How many feet? 0

FROM	TO	LITHOLOGIC LOG	FROM	TO	PLUGGING INTERVALS
			0	5	TOP SOIL
			5	25	BENTONITE GROUT
			25	113	DIRT
			113	123	BENTONITE GROUT
			123	130	CHLORINATED SAND
			0	0	
			0	0	
			0	0	
			0	0	
			0	0	

**RECEIVED**  
 FEB 05 2009  
 BUREAU OF WATER

7 CONTRACTOR'S OR LANDOWNER'S CERTIFICATION: This water well was Plugged under my jurisdiction and was completed on (mo/day/year) 12/18/08 and this record is true to the best of my knowledge and belief. Kansas water well Contractor's License No. 179 This Water Well Record was completed on (mo/day/yr) 01/27/09 under the business name of JOE'S WELL SERVICE, INC. by (signature) *Josiah Curt*