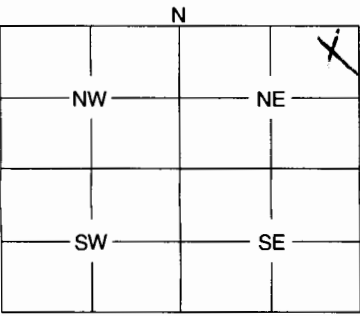


1	LOCATION OF WATER WELL:	Fraction NE 1/4	Section Number 8	Township Number T-21-S	Range Number R-5-W E/W
County: McPherson					

Distance and direction from nearest town or city street address of well if located within city?

6 West 1 North from Cheyenne & 2nd 233 ft ~~and~~ south 424 ft ~~and~~ West to water well

2	WATER WELL OWNER: Henry T Ensz	Board of Agriculture, Division of Water Resources
RR #, St. Address, Box #: Cheyenne RD		Application Number:
City, State, ZIP Code: Inman KS 67546		

3	MARK WELL'S LOCATION WITH AN "X" IN SECTION BOX:	4	DEPTH OF WELL 31 ft.
		WELL'S STATIC WATER LEVEL 8 ft.	
		WELL WAS USED AS:	
		1 Domestic (5) Public Water Supply 9 Dewatering 2 Irrigation 6 Oil Field Water Supply 10 Monitoring Well 3 Feedlot 7 Domestic (Lawn & Garden) 11 Injection Well 4 Industrial 8 Air Conditioning 12 Other	
Was a chemical / bacteriological sample submitted to Department? Yes No X			
If yes, mo/day/yr sample was submitted			
Water Well Disinfected: Yes X No 80 oz			

5	TYPE OF BLANK CASING USED:			
1 Steel 3 RMP (SR) 5 Wrought 7 Fiberglass 9 Other (Specify below) Rock-limestone 2 PVC 4 ABS 6 Asbestos-Cement 8 Concrete Tile				
Blank casing diameter in. Was casing pulled? Yes No If yes, how much				
Casing height above or below land surface in. Hand				

6	GROUT PLUG MATERIAL: 1 Neat cement (2) Cement grout 3 Bentonite 4 Other			
Grout Plug Intervals: From 31 ft. to 4 ft., From 4 ft. to 3 ft., From to ft.				
What is the nearest source of possible contamination: Road gravel Concrete				
1 Septic tank 6 Seepage pit 11 Fuel storage 16 Other (specify below) 2 Sewer lines 7 Pit privy 12 Fertilizer storage 3 Watertight sewer lines 8 Sewage lagoon 13 Insecticide storage 4 Natural lines 9 Feedyard 14 Abandoned water well 5 Cess pool 10 Livestock pens 15 Oil well/Gas well				
Direction from well? North How many feet? 50				

FROM	TO	PLUGGING MATERIALS
31	4	Coarse Road gravel
4	3	Concrete
3	0	Top soil backfill

7	CONTRACTOR'S OF LANDOWNER'S CERTIFICATION: This water well was plugged under my jurisdiction and was completed on (mo/day/year) and this record is true to the best of my knowledge and belief. Kansas Water Well Contractor's License No. This Water Well Record was completed on (mo/day/year)
by (signature) Henry T Ensz under the business name of	

INSTRUCTIONS: Use typewriter or ball point pen. Please press firmly and print clearly. Please fill in blanks, underline or circle the correct answers. Send top three copies to Kansas Department of Health and Environment, Bureau of Water, Geology Section, 1000 SW Jackson St., Ste. 420, Topeka, Kansas 66612-1367. Telephone: 785/296-5522. Send one to Water Well Owner and retain one for your records.