WATER WELL RECORD Form WWC-5 KSA 82a-1212

1 LOCATION OF WATER WELL: County: McPherson | Fraction: SW ¼ SW ¼ SE ¼ | Section Number: 8 | Township Number: T 21 S | Range Number: R 5 (E) W

Distance and direction from nearest town or city street address of well if located within city? 6½ mi W of Inman, KS

2 WATER WELL OWNER: [redacted] Arnold Witorff

RR#, St. Address, Box # : Rt 2 | Board of Agriculture, Division of Water Resources

City, State, ZIP Code : Inman, KS 67546 | Application Number:

3 LOCATE WELL'S LOCATION WITH AN "X" IN SECTION BOX:

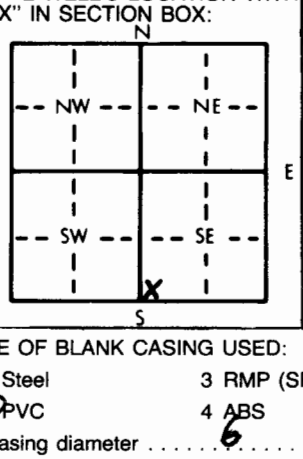

4 DEPTH OF COMPLETED WELL 49 ft. ELEVATION:

Depth(s) Groundwater Encountered 1. ft. 2. ft. 3. ft.

WELL'S STATIC WATER LEVEL 7 ft. below land surface measured on mo/day/yr 8-12-81

Pump test data: Well water was 47 ft. after 2 hours pumping 12 gpm

Est. Yield 12 gpm: Well water was ft. after hours pumping gpm

Bore Hole Diameter 10 in. to 52 ft., and in. to ft.

WELL WATER TO BE USED AS: (1) Domestic 2 Irrigation 3 Feedlot 4 Industrial 5 Public water supply 6 Oil field water supply 7 Lawn and garden only 8 Air conditioning 9 Dewatering 10 Observation well 11 Injection well (12) Other (Specify below) Stock

Was a chemical/bacteriological sample submitted to Department? Yes No X; If yes, mo/day/yr sample was submitted

Water Well Disinfected? Yes X No

5 TYPE OF BLANK CASING USED: 1 Steel 3 RMP (SR) 5 Wrought iron 6 Asbestos-Cement 7 Fiberglass 8 Concrete tile 9 Other (specify below) (2) PVC 4 ABS

CASING JOINTS: Glued X Clamped Welded Threaded

Blank casing diameter 6 in. to 39 ft., Dia in. to ft., Dia in. to ft.

Casing height above land surface 24 in., weight 3.25 lbs./ft. Wall thickness or gauge No. 160

TYPE OF SCREEN OR PERFORATION MATERIAL: (7) PVC 1 Steel 2 Brass 3 Stainless steel 4 Galvanized steel 5 Fiberglass 6 Concrete tile 8 RMP (SR) 9 ABS 10 Asbestos-cement 11 Other (specify) 12 None used (open hole)

SCREEN OR PERFORATION OPENINGS ARE: 1 Continuous slot (3) Mill slot 2 Louvered shutter 4 Key punched 5 Gauzed wrapped 6 Wire wrapped 7 Torch cut 8 Saw cut 9 Drilled holes 10 Other (specify) 11 None (open hole)

SCREEN-PERFORATED INTERVALS: From 39 ft. to 49 ft., From ft. to ft.

From ft. to ft., From ft. to ft.

GRAVEL PACK INTERVALS: From 30 ft. to 52 ft., From ft. to ft.

From ft. to ft., From ft. to ft.

6 GROUT MATERIAL: (1) Neat cement 2 Cement grout 3 Bentonite 4 Other

Grout Intervals: From 0 ft. to 10 ft., From ft. to ft., From ft. to ft.

What is the nearest source of possible contamination:

1 Septic tank 2 Sewer lines 3 Watertight sewer lines 4 Lateral lines 5 Cess pool 6 Seepage pit 7 Pit privy 8 Sewage lagoon 9 Feedyard 10 Livestock pens 11 Fuel storage 12 Fertilizer storage 13 Insecticide storage 14 Abandoned water well 15 Oil well/Gas well (16) Other (specify below) open field

Direction from well? How many feet?

FROM	TO	LITHOLOGIC LOG	FROM	TO	LITHOLOGIC LOG
0	11	dune Sand			
12	12	gr clay			
12	31	F Sand			
31	44	Clay			
44	47	Pebble + Sand			
47	52	Red Shale			

7 CONTRACTOR'S OR LANDOWNER'S CERTIFICATION: This water well was (1) constructed, (2) reconstructed, or (3) plugged under my jurisdiction and was completed on (mo/day/year) 8-12-81 and this record is true to the best of my knowledge and belief. Kansas Water Well Contractor's License No. 382 This Water Well Record was completed on (mo/day/yr) 3-5-82 under the business name of Miller Water Well by (signature) Ezra Miller

INSTRUCTIONS: Use typewriter or ball point pen, *PLEASE PRESS FIRMLY* and *PRINT* clearly. Please fill in blanks, underline or circle the correct answers. Send top three copies to Kansas Department of Health and Environment, Division of Environment, Environmental Geology Section, Topeka, KS 66620. Send one to WATER WELL OWNER and retain one for your records.

OFFICE USE ONLY