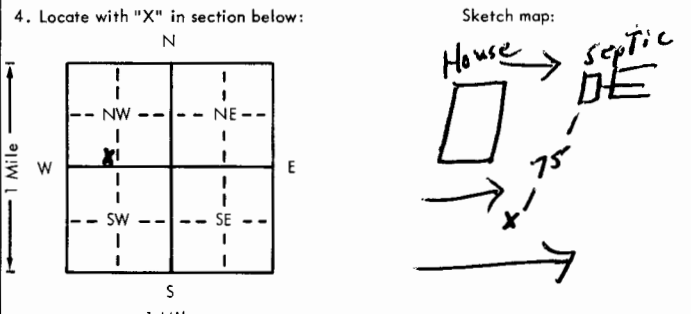


USE TYPEWRITER OR BALL
POINT PEN-PRESS FIRMLY,
PRINT CLEARLY.

WATER WELL RECORD
KSA 82a-1201-1215

Kansas Department of Health and
Environment-Division of Environment
(Water well Contractors)
Topeka, Kansas 66620

1. Location of well:	County McPherson	Fraction SE 1/4 SW 1/4 NW 1/4	Section number 16	Township number T 21 S	Range number R 5 E
2. Distance and direction from nearest town or city: Street address of well location if in city:	9 mi N, 2 E of Hutchinson		3. Owner of well: Mike Lee R.R. or street: Rt 2 City, state, zip code: Inman, KS 67546		
4. Locate with "X" in section below:	Sketch map: 		6. Bore hole dia. 10 in. Completion date 4-16-79 Well depth 60 ft.		
5. Type and color of material		From	To	7. Cable tool <input checked="" type="checkbox"/> Rotary <input type="checkbox"/> Driven <input type="checkbox"/> Dug <input type="checkbox"/> Hollow rod <input type="checkbox"/> Jetted <input type="checkbox"/> Bored <input type="checkbox"/> Reverse rotary	
	Dune Sand	0	15	8. Use: <input checked="" type="checkbox"/> Domestic <input type="checkbox"/> Public supply <input type="checkbox"/> Industry <input type="checkbox"/> Irrigation <input type="checkbox"/> Air conditioning <input type="checkbox"/> Stock <input type="checkbox"/> Lawn <input type="checkbox"/> Oil field water <input type="checkbox"/> Other	
	Gray Clay	15	19	9. Casing: Material PLST Height: Above or below Threaded <input type="checkbox"/> Welded <input type="checkbox"/> Surface 24 in. RMP <input checked="" type="checkbox"/> PVC <input type="checkbox"/> Weight 1.95 lbs./ft. Dia. 6 in. to 60 ft. depth Wall Thickness: inches or Dia. 6 in. to 60 ft. depth gage No. 200	
	Brown Sand - pieces wood	19	25	10. Screen: Manufacturer's name Sunflower Type RMP Dia. 6 Slot/ gauze .035 Length 10' Set between 50 ft. and 60 ft. Gravel pack? Yes Size range of material F-1/2	
	Gray Sand	25	38	11. Static water level: 8 ft. below land surface Date 4-16-79	
	Gray Clay	38	50	12. Pumping level below land surfaces: 21 ft. after 10 hrs. pumping 20 g.p.m. ft. after hrs. pumping g.p.m. Estimated maximum yield 35 g.p.m.	
	Gray Sand + Sea Shells	50	63	13. Water sample submitted: Yes <input checked="" type="checkbox"/> No <input type="checkbox"/> Date	
	Red Shale	63	64	14. Well head completion: 24 inches above grade Pitless adapter	
				15. Well grouted? Yes With: 4 Neat cement <input type="checkbox"/> Bentonite <input type="checkbox"/> Concrete <input type="checkbox"/> Depth: From 3 ft. to 10 ft.	
				16. Nearest source of possible contamination: ft. 25 Direction NE Type Septic Well disinfected upon completion? <input checked="" type="checkbox"/> Yes <input type="checkbox"/> No	
			17. Pump: <input checked="" type="checkbox"/> Not installed Manufacturer's name Model number HP Volts Length of drop pipe ft. capacity g.p.m. Type: <input type="checkbox"/> Submersible <input type="checkbox"/> Turbine <input type="checkbox"/> Jet <input type="checkbox"/> Reciprocating <input type="checkbox"/> Centrifugal <input type="checkbox"/> Other		
18. Elevation:	19. Remarks:		20. Water well contractor's certification: This well was drilled under my jurisdiction and this report is true to the best of my knowledge and belief. Miller Water Well 187 Business name License No. Address Hutchinson, KS Signed Egan Miller Date 5-17-79 Authorized representative		

Forward the white, blue and pink copies to the Department of Health and Environment

Form WWC-5