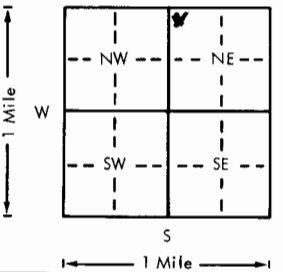
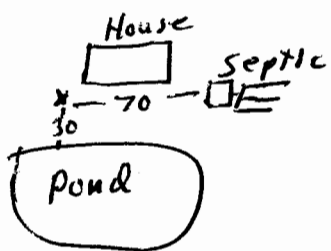


USE TYPEWRITER OR BALL
POINT PEN-PRESS FIRMLY,
PRINT CLEARLY.

WATER WELL RECORD
KSA 82a-1201-1215

Kansas Department of Health and
Environment-Division of Environment
(Water well Contractors)
Topeka, Kansas 66620

1. Location of well:		County McPherson	Fraction NW 1/4 NW 1/4 NE 1/4	Section number 17	Township number T 21 S R 5 E	Range number 5
2. Distance and direction from nearest town or city: 6 1/2 Mi. W +		3. Owner of well: Woodcraft Builders R.R. or street: Ros City, state, zip code: Hutchinson, KS 67501				
Street address of well location if in city: Inman, KS						
4. Locate with "X" in section below: 		Sketch map: 		6. Bore hole dia. 16 in. Completion date 5-12-78 Well depth 57 ft.		
5. Type and color of material		From	To	7. Cable tool <input checked="" type="checkbox"/> Rotary <input type="checkbox"/> Driven <input type="checkbox"/> Dug <input type="checkbox"/> Hollow rod <input type="checkbox"/> Jetted <input type="checkbox"/> Bored <input type="checkbox"/> Reverse rotary		
Brown Clay		0	45	8. Use: <input checked="" type="checkbox"/> Domestic <input type="checkbox"/> Public supply <input type="checkbox"/> Industry <input type="checkbox"/> Irrigation <input type="checkbox"/> Air conditioning <input type="checkbox"/> Stock <input type="checkbox"/> Lawn <input type="checkbox"/> Oil field water <input type="checkbox"/> Other		
Fine Gray Sand - pebbles		45	50	9. Casing: Material Plst Height: Above or below Threaded <input type="checkbox"/> Welded <input type="checkbox"/> Surface 48 in. RMP <input checked="" type="checkbox"/> PVC <input type="checkbox"/> Weight 1.95 lbs./ft. Dia. 6 in. to 57 ft. depth Wall Thickness: inches or Dia. <input type="checkbox"/> in. to <input type="checkbox"/> ft. depth gage No. 200		
Gray Clay		50	55	10. Screen: Manufacturer's name Sunflower Type RMP Dia. 6 Slot/gauze .035 Length 10 Set between 41 ft. and 51 ft. ft. and <input type="checkbox"/> ft. Gravel pack? Yes Size range of material F-1/2		
				11. Static water level: <input type="checkbox"/> mo./day/yr. 3 ft. below land surface Date 5-8-79		
				12. Pumping level below land surfaces: 43 ft. after 8 hrs. pumping 20 g.p.m. ft. after <input type="checkbox"/> hrs. pumping <input type="checkbox"/> g.p.m. Estimated maximum yield 20 g.p.m.		
				13. Water sample submitted: <input type="checkbox"/> mo./day/yr. <input type="checkbox"/> Yes <input checked="" type="checkbox"/> No Date <input type="checkbox"/>		
				14. Well head completion: <input type="checkbox"/> Pitless adapter 48 Inches above grade		
				15. Well grouted? Yes With: <input checked="" type="checkbox"/> Neat cement <input type="checkbox"/> Bentonite <input type="checkbox"/> Concrete Depth: From 0 ft. to 6 ft.		
				16. Nearest source of possible contamination: ft. 30 Direction S Type pond Well disinfected upon completion? <input checked="" type="checkbox"/> Yes <input type="checkbox"/> No		
				17. Pump: <input checked="" type="checkbox"/> Not installed Manufacturer's name <input type="checkbox"/> Model number <input type="checkbox"/> HP <input type="checkbox"/> Volts <input type="checkbox"/> Length of drop pipe <input type="checkbox"/> ft. capacity <input type="checkbox"/> g.p.m. Type: <input type="checkbox"/> Submersible <input type="checkbox"/> Turbine <input type="checkbox"/> Jet <input type="checkbox"/> Reciprocating <input type="checkbox"/> Centrifugal <input type="checkbox"/> Other		
18. Elevation:		19. Remarks:		20. Water well contractor's certification: This well was drilled under my jurisdiction and this report is true to the best of my knowledge and belief. Miller Waterwell 137 Business name Hutchinson, KS License No. <input type="checkbox"/> Address Egan Mills Date 5-20-78 Signed Egan Mills Authorized representative		
Topography: <input type="checkbox"/> Hill <input type="checkbox"/> Slope <input checked="" type="checkbox"/> Upland <input type="checkbox"/> Valley						

Forward the white, blue and pink copies to the Department of Health and Environment

Form WWC-5