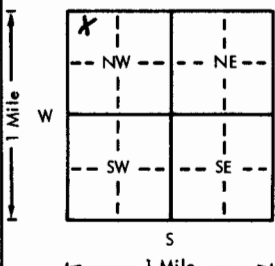
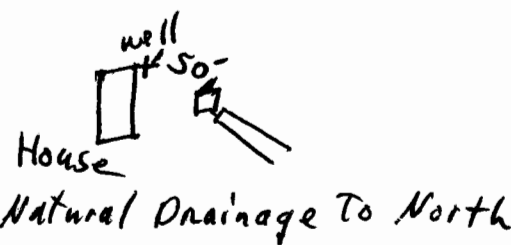


USE TYPEWRITER OR BALL
POINT PEN-PRESS FIRMLY,
PRINT CLEARLY.

WATER WELL RECORD
KSA 82a-1201-1215

Kansas Department of Health and
Environment-Division of Environment
(Water well Contractors)
Topeka, Kansas 66620

1. Location of well:		County <u>McPherson</u>	Fraction <u>NW 1/4 NW 1/4 NW 1/4</u>	Section number <u>30</u>	Township number <u>T 21</u>	Range number <u>S R 5</u>
2. Distance and direction from nearest town or city: <u>8 mi N of 30th</u>		3. Owner of well: <u>Dale Berthelson</u>		R.R. or street: <u>RT 3</u>		
Street address of well location if in city: <u>+ Plum Hutchinson</u>		City, state, zip code: <u>Inman, KS 67546</u>				
4. Locate with "X" in section below:		Sketch map:		6. Bore hole dia. <u>10"</u> in. Completion date <u>4-21-76</u>		
				Well depth <u>85' 5" - 85' 4"</u>		
5. Type and color of material		From		To		7. <input checked="" type="checkbox"/> Cable tool <input checked="" type="checkbox"/> Rotary <input type="checkbox"/> Driven <input type="checkbox"/> Dug
<u>Dune Sand</u>		<u>0</u>		<u>5</u>		<input type="checkbox"/> Hollow rod <input type="checkbox"/> Jetted <input type="checkbox"/> Bored <input type="checkbox"/> Reverse rotary
<u>clay - brown + gray + white</u>		<u>5</u>		<u>22</u>		8. Use: <input checked="" type="checkbox"/> Domestic <input type="checkbox"/> Public supply <input type="checkbox"/> Industry
<u>rock</u>						<input type="checkbox"/> Irrigation <input type="checkbox"/> Air conditioning <input type="checkbox"/> Stock
<u>clay reddish with white</u>		<u>22</u>		<u>33</u>		<input type="checkbox"/> Lawn <input type="checkbox"/> Oil field water <input type="checkbox"/> Other
<u>rock</u>						9. Casings: Material <u>Plst</u> Height <u>Above</u> or below
<u>shale red + blue</u>		<u>33</u>		<u>85</u>		Threaded <input type="checkbox"/> Welded <input type="checkbox"/> Surface <u>12</u> in.
						RMP <input checked="" type="checkbox"/> PVC <input type="checkbox"/> Weight <u>1.95</u> lbs./ft.
						Dia. <u>6</u> in. to <u>42</u> ft. depth Wall Thickness: inches or
						Dia. <u> </u> in. to <u> </u> ft. depth Gauge No. <u>200</u>
						10. Screen: Manufacturer's name <u>Dresser-Howell</u>
						Type <u>RMP</u> Dia. <u> </u>
						Slot/gauze <u> </u> Length <u> </u>
						Set between <u>None</u> ft. and <u> </u> ft.
						Gravel pack? <u>No</u> Size range of material <u> </u>
						11. Static water level: <u>9</u> ft. below land surface Date <u>4-22-76</u>
						12. Pumping level below land surfaces:
						<u>52</u> ft. after <u>1</u> hrs. pumping <u>15</u> g.p.m.
						<u> </u> ft. after <u> </u> hrs. pumping <u> </u> g.p.m.
						Estimated maximum yield <u>20</u> g.p.m.
						13. Water sample submitted: <u> </u> mo./day/yr.
						Yes <input checked="" type="checkbox"/> No <input type="checkbox"/> Date <u> </u>
						14. Well head completion: <u> </u>
						<input checked="" type="checkbox"/> Pitless adapter <u>12</u> inches above grade
						15. Well grouted? <u>yes</u>
						With: <input checked="" type="checkbox"/> Neat cement <input type="checkbox"/> Bentonite <input type="checkbox"/> Concrete
						Depth: From <u>30</u> ft. to <u>13</u> ft.
						16. Nearest source of possible contamination:
						ft. <u>50</u> Direction <u>SE</u> Type <u>sewer</u>
						Well disinfected upon completion? <input checked="" type="checkbox"/> Yes <input type="checkbox"/> No
						17. Pump: <u> </u> Not installed
						Manufacturer's name <u>Valley Steel</u>
						Model number <u>S1208</u> HP <u>15</u> Volts <u>230</u>
						Length of drop pipe <u>70</u> ft. capacity <u>12</u> g.p.m.
						Type: <input checked="" type="checkbox"/> Submersible <input type="checkbox"/> Turbine
						<input type="checkbox"/> Jet <input type="checkbox"/> Reciprocating
						<input type="checkbox"/> Centrifugal <input type="checkbox"/> Other
18. Elevation:		19. Remarks:		20. Water well contractor's certification:		
Topography: <input type="checkbox"/> Hill <input type="checkbox"/> Slope <input type="checkbox"/> Upland <input checked="" type="checkbox"/> Valley				This well was drilled under my jurisdiction and this report is true to the best of my knowledge and belief.		
				<u>Miller Water Well Serv. Inc.</u> License No. <u>137</u>		
				Business name <u>Hutchinson, KS</u>		
				Address <u>400 Mill</u>		
				Signed <u> </u> Date <u>6-17-76</u>		
				Authorized representative		

Forward the white, blue and pink copies to the Department of Health and Environment

Form WWC-5