306

Rice

Darling Drilling Co.

Residence Phone 662-3991

1211 W. 4th
Hutchinson, Kansas 67501

Office Phone 662-7901

DRILLER'S TEST LOG

Customer's Name Graces Children Home Date May 7 - 1971

Address _____ Test No. 1

County Rice Quarter NW Section 28 Township 21 Range 7

DRILLED FOOTAGE From	To	DESCRIPTION OF STRATA
0	5	Soil & Clay
5	20	Coarse Gravel
20	40	med sand Tight
40	50	med sand
50	55	med + coarse
55	71	coarse Sea gravel
71	72	shale

Indicate Test Location By an X

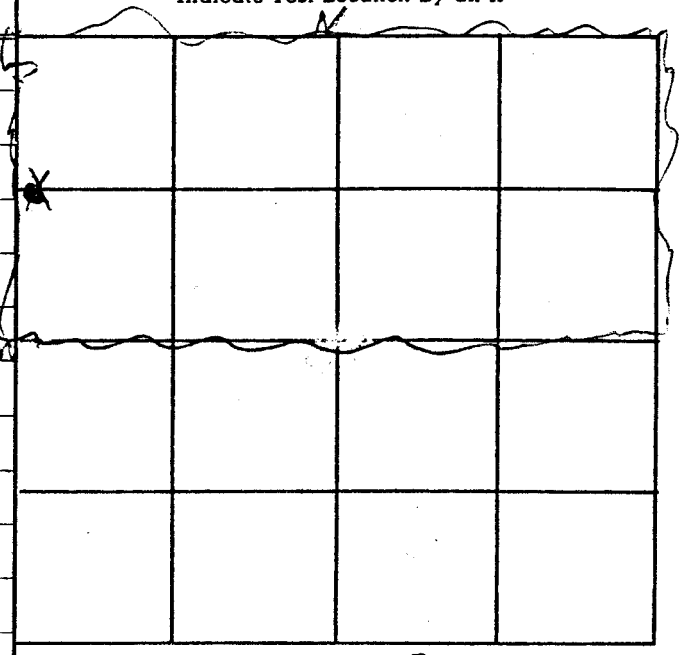

Static Water Level: _____

REMARKS: 1200 GPM
Took water sample

Clyde Bailey Drlg