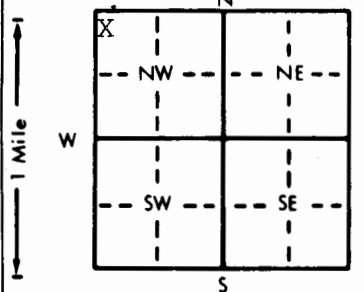


1 LOCATION OF WATER WELL: Fraction NW 1/4 NW 1/4 NW 1/4 Section Number 4 Township Number T 21 S Range Number R 7 **EW**

Distance and direction from nearest town or city street address of well if located within city?
 1 E Saxmon 1 So 1/4 E

2 WATER WELL OWNER: American Salt Co.
 RR#, St. Address, Box #: Box 498 Board of Agriculture, Division of Water Resources
 City, State, ZIP Code: Lyons, KS 67554 I Test Well Application Number:

3 LOCATE WELL'S LOCATION WITH AN "X" IN SECTION BOX:  4 DEPTH OF COMPLETED WELL: 63 ft. ELEVATION: ...
 Depth(s) Groundwater Encountered 1... 10 ft. 2... ft. 3... ft.
 WELL'S STATIC WATER LEVEL ... 10.5 ft. below land surface measured on mo/day/yr 6-20-87
 Pump test data: Well water was N/A ft. after ... hours pumping ... gpm
 Est. Yield ... gpm: Well water was N/A ft. after ... hours pumping ... gpm
 Bore Hole Diameter ... 8 in. to ... ft., and ... in. to ... ft.
 WELL WATER TO BE USED AS:
 5 Public water supply 8 Air conditioning 11 Injection well
 1 Domestic 3 Feedlot 6 Oil field water supply 9 Dewatering 12 Other (Specify below)
 2 Irrigation 4 Industrial 7 Lawn and garden only **XX** Observation well
 Was a chemical/bacteriological sample submitted to Department? Yes... No... **X**...; If yes, mo/day/yr sample was submitted
 Water Well Disinfected? Yes **X** No

5 TYPE OF BLANK CASING USED:
 1 Steel 3 RMP (SR) 5 Wrought iron 8 Concrete tile CASING JOINTS: Glued **X** Clamped
XX PVC 4 ABS 6 Asbestos-Cement 9 Other (specify below) Welded
 7 Fiberglass Threaded
 Blank casing diameter 4 in. to 0 ft., Dia 4 in. to 53 ft., Dia
 Casing height above land surface 2 in., weight 160 lbs./ft. Wall thickness or gauge No.
 TYPE OF SCREEN OR PERFORATION MATERIAL:
 1 Steel 3 Stainless steel 5 Fiberglass **XX** PVC 10 Asbestos-cement
 2 Brass 4 Galvanized steel 6 Concrete tile 8 RMP (SR) 11 Other (specify)
 9 ABS 12 None used (open hole)
 SCREEN OR PERFORATION OPENINGS ARE:
 1 Continuous slot 3 Mill slot 5 Gauzed wrapped **XX** Saw cut 11 None (open hole)
 2 Louvered shutter 4 Key punched 6 Wire wrapped 9 Drilled holes
 7 Torch cut 10 Other (specify)
 SCREEN-PERFORATED INTERVALS: From 53 ft. to 63 ft., From ... ft. to ... ft.
 GRAVEL PACK INTERVALS: From 20 ft. to 63 ft., From ... ft. to ... ft.

6 GROUT MATERIAL: **XX** Neat cement 2 Cement grout 3 Bentonite 4 Other
 Grout intervals: From 0 ft. to 20 ft., From ... ft. to ... ft.
 What is the nearest source of possible contamination:
 1 Septic tank 4 Lateral lines 7 Pit privy 10 Livestock pens 14 Abandoned water well
 2 Sewer lines 5 Cess pool 8 Sewage lagoon 11 Fuel storage 15 Oil well/Gas well
 3 Watertight sewer lines 6 Seepage pit 9 Feedyard 12 Fertilizer storage 16 Other (specify below)
 13 Insecticide storage None

Direction from well? How many feet?

FROM	TO	LITHOLOGIC LOG	FROM	TO	LITHOLOGIC LOG
0	3	TS			
3	9	Clay			
9	63	Med. Sand			
63	--	Shale			

7 CONTRACTOR'S OR LANDOWNER'S CERTIFICATION: This water well was **XX** constructed, (2) reconstructed, or (3) plugged under my jurisdiction and was completed on (mo/day/year) 6-20-87 and this record is true to the best of my knowledge and belief. Kansas
 Water Well Contractor's License No. 451 This Water Well Record was completed on (mo/day/yr) 6-20-87
 under the business name of Craig Haldman Well Drilling by (signature) Mike C. Flowers

INSTRUCTIONS: Use typewriter or ball point pen. PLEASE PRESS FIRMLY and PRINT clearly. Please fill in blanks, underline or circle the correct answers. Send top three copies to Kansas Department of Health and Environment, Bureau of Water Protection, Topeka, Kansas 66620-7320, Telephone: 913-862-9360. Send one to WATER WELL OWNER and retain one for your records.