


STANGE #1

1 LOCATION OF WATER WELL: Fraction 65034 650 EL Section Number 9 Township Number T 21 S Range Number R 7 EW

Distance and direction from nearest town or city street address of well if located within city? SAXMAN 1/4 S 1/4 E 25 2E NORTHSIDE

2 WATER WELL OWNER: 5 STERLING DRILLING CO VIC STANGE RR, STERLING, KS. Board of Agriculture, Division of Water Resources Application Number: 782-123

3 LOCATE WELL'S LOCATION WITH AN "X" IN SECTION BOX:

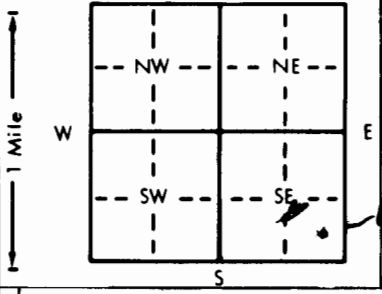

4 DEPTH OF COMPLETED WELL: 60 ft. ELEVATION: 7-23.82 ft. below land surface measured on mo/day/yr. Pump test data: Well water was 16 ft. after 7-23.82 hours pumping. Est. Yield: 778 gpm. Bore Hole Diameter: 7.718 in. to 6.0 in. WELL WATER TO BE USED AS: 5 Public water supply, 8 Air conditioning, 11 Injection well, 1 Domestic, 3 Feedlot, 6 Oil field water supply, 9 Dewatering, 12 Other (Specify below), 2 Irrigation, 4 Industrial, 7 Lawn and garden only, 10 Observation well. Was a chemical/bacteriological sample submitted to Department? No. Water Well Disinfected? No.

5 TYPE OF BLANK CASING USED: 1 Steel, 3 RMP (SR), 6 Asbestos-Cement, 9 Other (specify below), 2 PVC, 4 ABS, 7 Fiberglass. CASING JOINTS: Glued XX, Clamped, Welded, Threaded.

Blank casing diameter: 5 in. to 4.0 ft., Dia. Casing height above land surface: 12 in., weight: 265 lbs./ft. Wall thickness or gauge No.: 2.14.

TYPE OF SCREEN OR PERFORATION MATERIAL: 1 Steel, 3 Stainless steel, 5 Fiberglass, 8 RMP (SR), 11 Other (specify), 2 Brass, 4 Galvanized steel, 6 Concrete tile, 9 ABS, 12 None used (open hole).

SCREEN OR PERFORATION OPENINGS ARE: 1/8 5 Gauzed wrapped, 8 Saw cut, 11 None (open hole), 1 Continuous slot, 3 Mill slot, 6 Wire wrapped, 9 Drilled holes, 2 Louvered shutter, 4 Key punched, 7 Torch cut, 10 Other (specify).

SCREEN-PERFORATED INTERVALS: From 4.0 ft. to 6.0 ft. GRAVEL PACK INTERVALS: From 3.0 ft. to 6.0 ft.

6 GROUT MATERIAL: 1 Neat cement, 2 Cement grout, 3 Bentonite, 4 Other. Grout Intervals: From 0 ft. to 1.0 ft.

What is the nearest source of possible contamination: NONE. 1 Septic tank, 4 Lateral lines, 7 Pit privy, 10 Livestock pens, 14 Abandoned water well, 2 Sewer lines, 5 Cess pool, 8 Sewage lagoon, 11 Fuel storage, 15 Oil well/Gas well, 3 Watertight sewer lines, 6 Seepage pit, 9 Feedyard, 12 Fertilizer storage, 16 Other (specify below), 13 Insecticide storage.

Direction from well? How many feet?

Table with 2 columns: FROM, TO, LITHOLOGIC LOG. Row 1: 0, 5, SOIL. Row 2: 5, 15, SANDY CLAY. Row 3: 15, 60, GRAVEL.

7 CONTRACTOR'S OR LANDOWNER'S CERTIFICATION: This water well was (1) constructed, (2) reconstructed, or (3) plugged under my jurisdiction and was completed on (mo/day/year) 7-23-82 and this record is true to the best of my knowledge and belief. Kansas Water Well Contractor's License No. 389. This Water Well Record was completed on (mo/day/yr) 3-11-82 under the business name of RELSER WATER WELL SERV. INC. by (signature) Rudolph J. Bauer.