

USE TYPEWRITER OR BALL POINT PEN-PRESS FIRMLY, PRINT CLEARLY.

T R EW sec 1/4 1/4 1/4 No.

WATER WELL RECORD  
KSA 82a-1201-1215

Kansas State Dept. Of Health  
(Water Well Contractors)  
Forbes-Bldg. 740  
Topeka, Kansas 66620

SE NW NW


1 Location of well:	County: <u>Rice</u>	Township name:	Fraction: <u>NW 1/4</u>	Section number: <u>18</u>	Town number: <u>21 S</u>	Range number: <u>R 7 W</u>
---------------------	---------------------	----------------	-------------------------	---------------------------	--------------------------	----------------------------

Distance and direction from nearest town or city: \_\_\_\_\_

Street address of well location if in city: 3E 34 N Sterling

3 Owner of well: Robert McCrory

Address: RR Sterling, Kansas 67579

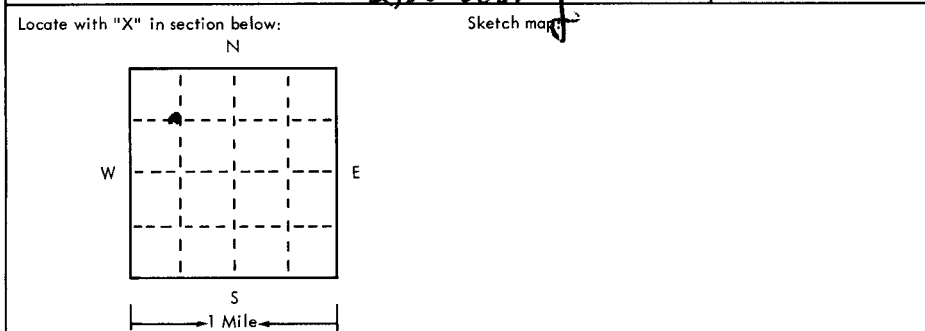

4 Well depth: 90 ft. Date of completion 10/7/75  
Well diameter 28 in.

5  Cable tool  Rotary  Driven  Dug  
 Hollow rod  Jetted  Bored  Reverse rotary

6 Use:  Domestic  Public supply  Industry  
 Irrigation  Air conditioning  Commercial  
 Test well

7 Casing: Material Steel Height: above / below  
Threaded  Welded  Surface 12 in.  
Diam. 16 in. to 51 ft. depth / Drive shoe?  Yes  No  
16 in. to 51 ft. depth

2 Type and color of material	From	To
Soil	0	2
Clay	2	12
Sand	12	30
Clay and sand	30	40
Clay	40	50
Clay and sand	50	55
Sand (med. coarse)	55	89
Shale	89	90
<u>Sodium chloride 1.25, 0 PPM.</u>		
<u>Sodium chloride 1.25, 0 PPM.</u>		
(use a second sheet if needed)		

8 Screen: Manufacturer Johnson  
Type Jubilee Dia. 16  
Slot/gauze fenest Length 39  
Set between 57 ft. and 90 ft.  
Fittings: Gravel pack  Yes  No Size range of material 1/8 - 1/4"

9 Static water level: 14 ft. below land surface Date 7/24/75

10 Pumping level below land surfaces:  
45 ft. after 1 hrs. pumping 1000 g.p.m.  
48.8 ft. after 1/2 hrs. pumping 800 g.p.m.  
Estimated maximum yield \_\_\_\_\_ g.p.m.

11 Water sample submitted:  
 Yes  No Date \_\_\_\_\_

12 Well head completion:  
 Pitless adapter  2 inches above grade

13 Well grouted?  Yes  No  
 Neat cement  Bentonite   
Depth: From 12 ft. to 10 ft.

14 Nearest source of possible contamination:  
ft. 600 Direction SE Type pit  
Well disinfected upon completion?  Yes  No

15 Pump:  Not installed  
Manufacturer's name Western Land Roller  
Model number 22CAN HP \_\_\_\_\_ Volts \_\_\_\_\_  
Length of drop pipe 40 ft. capacity 800 g.p.m.  
Type:  Submersible  Turbine  
 Jet  Reciprocating  
 Centrifugal  Other

16 Remarks: elevation

Topography:  
 Hill  
 Slope  
 Upland  
 Valley

17 Water well contractor's certification:  
This well was drilled under my jurisdiction and this report is true to the best of my knowledge and belief.

Darling Drilling Co. 189  
Business name License No.  
Address 211 West 4th Hutchinson, Ks.  
Signed Donald J. Kelly Date 10-7-75  
Authorized representative

21 NW 18 SE NW NW

Forward the white, blue and pink copies to the Kansas State Dept. Of Health.

Form WWC-5