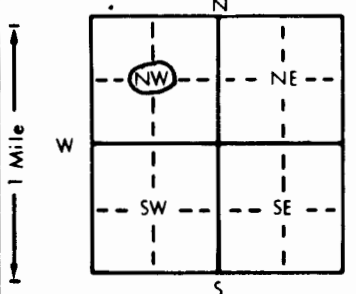


1 LOCATION OF WATER WELL: Fraction Near the Center Section Number 36 Township Number T 21 S Range Number R 7 E/W
 County: Rice $\frac{1}{4}$ $\frac{1}{4}$ NW $\frac{1}{4}$

Distance and direction from nearest town or city street address of well if located within city?
Approximately 8 miles and 1 1/2 miles south of Sterling, Ks.

2 WATER WELL OWNER: Loren Colle Board of Agriculture, Division of Water Resources
 RR#, St. Address, Box # : Route 2 Application Number: 39,811
 City, State, ZIP Code : Sterling, KS 67579

3 LOCATE WELL'S LOCATION WITH AN "X" IN SECTION BOX:

 4 DEPTH OF COMPLETED WELL: 55 ft. ELEVATION: unknown
 Depth(s) Groundwater Encountered 1. 1 ft. 2. 1 ft. 3. 1 ft.
 WELL'S STATIC WATER LEVEL 7 ft. below land surface measured on mo/day/yr
 Pump test data: Well water was not ch'd ft. after hours pumping gpm
 Est. Yield unknown gpm: Well water was ft. after hours pumping gpm
 Bore Hole Diameter 24 in. to 55 ft., and in. to ft.
 WELL WATER TO BE USED AS:
 5 Public water supply 8 Air conditioning 11 Injection well
 1 Domestic 3 Feedlot 6 Oil field water supply 9 Dewatering 12 Other (Specify below)
2 Irrigation 4 Industrial 7 Lawn and garden only 10 Monitoring well
 Was a chemical/bacteriological sample submitted to Department? Yes No x; If yes, mo/day/yr sample was submitted
 Water Well Disinfected? Yes No x

5 TYPE OF BLANK CASING USED:
 1 Steel 3 RMP (SR) 5 Wrought iron 8 Concrete tile CASING JOINTS: Glued Clamped
 2 PVC 4 ABS 6 Asbestos-Cement 9 Other (specify below) Welded x
 7 Fiberglass Threaded
 Blank casing diameter 16 in. to 26 ft., Dia in. to ft., Dia in. to ft.
 Casing height above land surface 12 in., weight 42.05 lbs./ft. Wall thickness or gauge No. 250
 TYPE OF SCREEN OR PERFORATION MATERIAL:
 1 Steel 3 Stainless steel 5 Fiberglass 7 PVC 10 Asbestos-cement
 2 Brass 4 Galvanized steel 6 Concrete tile 8 RMP (SR) 11 Other (specify)
 12 None used (open hole)
 SCREEN OR PERFORATION OPENINGS ARE:
 1 Continuous slot 3 Mill slot 5 Gauzed wrapped 8 Saw cut 11 None (open hole)
 2 Louvered shutter 4 Key punched 6 Wire wrapped 9 Drilled holes
 7 Torch cut 10 Other (specify) Bridge Slot
 SCREEN-PERFORATED INTERVALS: From 26 ft. to 34 ft., From ft. to ft.
 From 34 ft. to 54 ft., From ft. to ft.
 GRAVEL PACK INTERVALS: From 20 ft. to 55 ft., From ft. to ft.
 From ft. to ft., From ft. to ft.

6 GROUT MATERIAL: 1 Neat cement 2 Cement grout 3 Bentonite 4 Other
 Grout Intervals: From 0 ft. to 20 ft., From ft. to ft., From ft. to ft.
 What is the nearest source of possible contamination:
 1 Septic tank 4 Lateral lines 7 Pit privy 10 Livestock pens 14 Abandoned water well
 2 Sewer lines 5 Cess pool 8 Sewage lagoon 11 Fuel storage 15 Oil well/Gas well
 3 Watertight sewer lines 6 Seepage pit 9 Feedyard 12 Fertilizer storage 16 Other (specify below)
 13 Insecticide storage None Known
 Direction from well? How many feet?

FROM	TO	LITHOLOGIC LOG	FROM	TO	PLUGGING INTERVALS
0	7	Topsoil, clay, brown			
7	16	Sand and Gravel, fine, medium, coarse			
16	18	Clay, brown and black			
18	40	Sand and Gravel, fine, medium, coarse			
40	55	Sand and Gravel, fine, medium			

7 CONTRACTOR'S OR LANDOWNER'S CERTIFICATION: This water well was (1) constructed, (2) reconstructed, or (3) plugged under my jurisdiction and was completed on (mo/day/year) 5-23-90 and this record is true to the best of my knowledge and belief. Kansas Water Well Contractor's License No. 185. This Water Well Record was completed on (mo/day/yr) 5-30-90 under the business name of Clarke Well & Equipment, Inc. by (signature) Clarke Well & Equipment