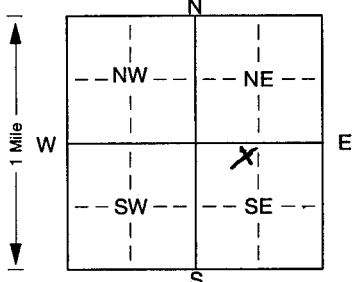


1 LOCATION OF WATER WELL: Fraction NE 1/4 NW 1/4 SE 1/4 Section Number 16 Township Number T 21 S Range Number R 8 E
 County: Rice

Distance and direction from nearest town or city street address of well if located within city?
808 N Sherwood in Sterling

2 WATER WELL OWNER: Hadley Hicks
 RR#, St. Address, Box # : 808 N Sherwood Board of Agriculture, Division of Water Resources
 City, State, ZIP Code : Sterling, KS 67579 Application Number:

3 LOCATE WELL'S LOCATION WITH AN "X" IN SECTION BOX:  4 DEPTH OF COMPLETED WELL: 40 ft. ELEVATION:
 Depth(s) Groundwater Encountered 1. ft. 2. ft. 3. ft.
 WELL'S STATIC WATER LEVEL ... 12 ... ft. below land surface measured on mo/day/yr ... 4-6-00 ...
 Pump test data: Well water was ... 13 ... ft. after ... 114 ... hours pumping ... 25 ... gpm
 Est. Yield gpm: Well water was ft. after hours pumping gpm
 Bore Hole Diameter. ... 8 ... in. to ... 4.3 ... ft., and, in. to ft.
 WELL WATER TO BE USED AS: 5 Public water supply 8 Air conditioning 11 Injection well
 1 Domestic 3 Feedlot 6 Oil field water supply 9 Dewatering 12 Other (Specify below)
 2 Irrigation 4 Industrial 1 Domestic (lawn & garden) 10 Monitoring well
 Was a chemical/bacteriological sample submitted to Department? Yes. No. X ...; If yes, mo/day/yr sample was submitted
 Water Well Disinfected? Yes X No

5 TYPE OF BLANK CASING USED: 5 Wrought iron 8 Concrete tile CASING JOINTS: Glued. X Clamped.
 1 Steel 3 RMP (SR) 6 Asbestos-Cement 9 Other (specify below) Welded
2 PVC 4 ABS 7 Fiberglass Threaded.
 Blank casing diameter ... 5 ... in. to ... 30 ... ft., Dia in. to ft., Dia in. to ft.
 Casing height above land surface. 12 ... in., weight ... 2.29 ... lbs./ft. Wall thickness or gauge No. ... 160 ...
 TYPE OF SCREEN OR PERFORATION MATERIAL: 7 PVC 10 Asbestos-cement
 1 Steel 3 Stainless steel 5 Fiberglass 8 RMP (SR) 11 Other (specify)
 2 Brass 4 Galvanized steel 6 Concrete tile 9 ABS 12 None used (open hole)
 SCREEN OR PERFORATION OPENINGS ARE: 5 Gauzed wrapped 8 Saw cut 11 None (open hole)
 1 Continuous slot 3 Mill slot 6 Wire wrapped 9 Drilled holes
 2 Louvered shutter 4 Key punched 7 Torch cut 10 Other (specify) ft.
 SCREEN-PERFORATED INTERVALS: From ... 30 ... ft. to ... 40 ... ft., From ft. to ft.
 From ft. to ft., From ft. to ft.
 GRAVEL PACK INTERVALS: From ... 22 ... ft. to ... 43 ... ft., From ft. to ft.
 From ft. to ft., From ft. to ft.

6 GROUT MATERIAL: 1 Neat cement 2 Cement grout 3 Bentonite 4 Other
 Grout Intervals: From ... 2 ... ft. to ... 22 ... ft., From ft. to ft., From ft. to ft.
 What is the nearest source of possible contamination:
 1 Septic tank 4 Lateral lines 7 Pit privy 11 Fuel storage 14 Abandoned water well
 2 Sewer lines 5 Cess pool 8 Sewage lagoon 12 Fertilizer storage 15 Oil well/Gas well
6 Watertight sewer lines 6 Seepage pit 9 Feedyard 13 Insecticide storage 16 Other (specify below)
 Direction from well? S How many feet? 15

FROM	TO	LITHOLOGIC LOG	FROM	TO	PLUGGING INTERVALS
0	3	Sandy Silt			
3	7	Br Clay			
7	43	Sand + Gravel			

7 CONTRACTOR'S OR LANDOWNER'S CERTIFICATION: This water well was 1 constructed, (2) reconstructed, or (3) plugged under my jurisdiction and was completed on (mo/day/year) ... 4-6-00 ... and this record is true to the best of my knowledge and belief. Kansas Water Well Contractor's Licence No. ... 447 ... This Water Well Record was completed on (mo/day/yr) ... 4-12-00 ... under the business name of Miller Drilling by (signature) Eg Miller