


1 LOCATION OF WATER WELL: Fraction Section Number Township Number Range Number
County: Rice SE 1/4 NE 1/4 NW 1/4 21 T 21 S R 8 E/W
Distance and direction from nearest town or city street address of well if located within city?
327 N. Broadway

2 WATER WELL OWNER: Sterling Power Plant
RR#, St. Address, Box #: 327 N. Broadway
City, State, ZIP Code: Sterling, KS 67579
Board of Agriculture, Division of Water Resources
Application Number:

3 LOCATE WELL'S LOCATION WITH AN 'X' IN SECTION BOX:
4 DEPTH OF COMPLETED WELL 14.93 ft. ELEVATION:
WELL'S STATIC WATER LEVEL 7.54 ft. below land surface measured on mo/day/yr 2-4-6-05
Pump test data: Well water was ft. after hours pumping gpm
Est. Yield gpm: Well water was ft. after hours pumping gpm
WELL WATER TO BE USED AS: 5 Public water supply 8 Air conditioning 11 Injection well
1 Domestic 3 Feedlot 6 Oil field water supply 9 Dewatering 12 Other (Specify below)
2 Irrigation 4 Industrial 7 Domestic (lawn & garden) XX Monitoring well
Was a chemical/bacteriological sample submitted to Department? Yes No XX; If yes, mo/day/yr sample was submitted
Water Well Disinfected? Yes XX

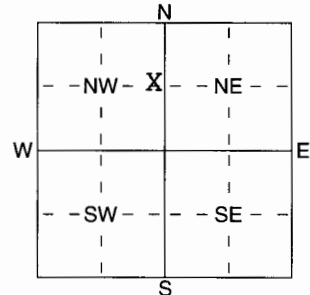

5 TYPE OF BLANK CASING USED: 1 Steel 3 RMP (SR) 5 Wrought iron 8 Concrete tile CASING JOINTS: Glued Clamped
XX2 PVC 4 ABS 6 Asbestos-Cement 9 Other (specify below) Welded
Blank casing diameter 2 in. to 5.3 ft., Dia in. to ft., Dia in. to ft.
Casing height above land surface 2 Below in., weight lbs./ft. Wall thickness or gauge No. Sch 40
TYPE OF SCREEN OR PERFORATION MATERIAL: XX PVC 10 Asbestos-Cement
1 Steel 3 Stainless Steel 5 Fiberglass 8 RMP (SR) 11 Other (Specify)
2 Brass 4 Galvanized Steel 6 Concrete tile 9 ABS 12 None used (open hole)
SCREEN OR PERFORATION OPENINGS ARE: XX Mill slot .010 5 Gauzed wrapped 8 Saw cut 11 None (open hole)
1 Continuous slot 2 Louvered shutter 4 Key punched 6 Wire wrapped 9 Drilled holes 10 Other (specify) ft.
SCREEN-PERFORATED INTERVALS: From 14.93 to 5.3 ft., From ft. to ft.
GRAVEL PACK INTERVALS: From 15.3 to 4.3 ft., From ft. to ft.

6 GROUT MATERIAL: 1 Neat cement 2 Cement grout XX Bentonite 4 Other
Grout Intervals: From 4.3 ft. to 0 ft., From ft. to ft., From ft. to ft.
What is the nearest source of possible contamination:
1 Septic tank 4 Lateral lines 7 Pit privy XX Fuel storage 14 Abandoned water well
2 Sewer lines 5 Cess pool 8 Sewage lagoon 12 Fertilizer storage 15 Oil well/Gas well
3 Watertight sewer lines 6 Seepage pit 9 Feedyard 13 Insecticide storage 16 Other (specify below)
Direction from well? Immediate Vicinity How many feet?

Table with columns: FROM, TO, LITHOLOGIC LOG, FROM, TO, PLUGGING INTERVALS. Row 1: 0, 12', Tan clay. Row 2: 12', 15', Sand.

MW # 7

7 CONTRACTOR'S OR LANDOWNER'S CERTIFICATION: This water well was constructed, (2) reconstructed, or (3) plugged under my jurisdiction and was completed on (mo/day/year) 2-7-05 and this record is true to the best of my knowledge and belief. Kansas Water Well Contractor's Licence No 665 This Water Well Record was completed on (mo/day/yr) 2-18-95 under the business name of Pratt Well Service Environmental by (signature)