

CORRECTION(S) TO WATER WELL RECORD (WWC-5)

(to rectify lacking or incorrect information)

County: Rice

Location listed as:

Section-Township-Range: \_\_\_\_\_

Fraction (  $\frac{1}{4}$   $\frac{1}{4}$   $\frac{1}{4}$ ): \_\_\_\_\_

Location ~~changed to:~~

16-21S-8W

NE SE SW

Other changes: Initial statements: CO. listed: Reno

Changed to: Rice Co.

Comments: \_\_\_\_\_

verification method: location of address on mapquest.com places

well in Rice Co.

initials: E.P.C. date: 11/15/2005


submitted by: Kansas Geological Survey, Data Resources Library, 1930 Constant Ave., Lawrence, KS 66047-3726

to: Kansas Dept of Health & Environment, Bureau of Water, 1000 SW Jackson, Suite 420, Topeka, KS 66612-1367.

1 LOCATION OF WATER WELL:	Fraction	Section Number	Township Number	Range Number
County: Reno	NE 1/4 SE 1/4 SW 1/4	16	T 21 S	R 8 E (W)

Distance and direction from nearest town or city street address of well if located within city?  
 At 125 W. Cooper Ave. - directly in front of administration building

2 WATER WELL OWNER: Sterling College  
 RR#, St. Address, Box # : 125 W. Cooper Ave. Board of Agriculture, Division of Water Resources  
 City, State, ZIP Code : Sterling, KS 67579 Application Number:

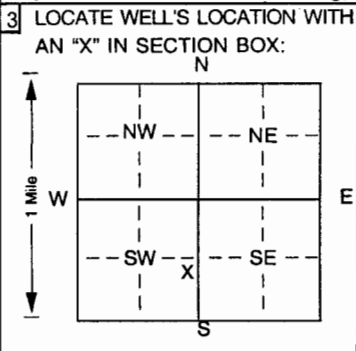

4 DEPTH OF COMPLETED WELL 50 ft. ELEVATION: unknown

Depth(s) Groundwater Encountered 1 ft. 2 ft. 3 ft. ft.

WELL'S STATIC WATER LEVEL 12.84 ft. below land surface measured on mo/day/yr 10/13/05

Pump test data: Well water was not checked ft. after hours pumping gpm

Est. Yield unknown gpm: Well water was ft. after hours pumping gpm

Bore Hole Diameter 14 in. to 50 ft., and in. to ft.

WELL WATER TO BE USED AS:

5 Public water supply	8 Air conditioning	11 Injection well
1 Domestic	3 Feedlot	6 Oil field water supply
2 Irrigation	4 Industrial	7 Domestic (lawn & garden)
		10 Monitoring well

Was a chemical/bacteriological sample submitted to Department? Yes No  If yes, mo/day/yr sample was submitted

Water Well Disinfected? Yes No

5 TYPE OF BLANK CASING USED:

1 Steel	3 RMP (SR)	5 Wrought iron	8 Concrete tile	CASING JOINTS: Glued <input checked="" type="checkbox"/> Clamped
2 PVC	4 ABS	6 Asbestos-Cement	9 Other (specify below)	Welded
		7 Fiberglass		Threaded

Blank casing diameter 8 in. to 38 ft., Dia in. to ft., Dia in. to ft.

Casing height above land surface 24 in., weight 5.59 lbs./ft. Wall thickness or gauge No .332

TYPE OF SCREEN OR PERFORATION MATERIAL:

1 Steel	3 Stainless steel	5 Fiberglass	8 RMP (SR)	10 Asbestos-cement
2 Brass	4 Galvanized steel	6 Concrete tile	9 ABS	11 Other (specify)
				12 None used (open hole)

SCREEN OR PERFORATION OPENINGS ARE:

1 Continuous slot	3 Mill slot	5 Gauzed wrapped	8 Saw cut	11 None (open hole)
2 Louvered shutter	4 Key punched	6 Wire wrapped	9 Drilled holes	
		7 Torch cut	10 Other (specify)	ft.

SCREEN-PERFORATED INTERVALS: From 38 ft. to 48 ft., From ft. to ft.

GRAVEL PACK INTERVALS: From 24 ft. to 29 ft., From ft. to ft.

From 33 ft. to 50 ft., From ft. to ft.

6 GROUT MATERIAL: 1 Neat cement 2 Cement grout 3 Bentonite 4 Other Bentonite Holeplug

Topsoil

Grout Intervals: From 0 ft. to 4 ft., From 4 ft. to 24 ft., From 29 ft. to 33 ft.

What is the nearest source of possible contamination:

1 Septic tank	4 Lateral lines	7 Pit privy	10 Livestock pens	14 Abandoned water well
2 Sewer lines	5 Cess pool	8 Sewage lagoon	11 Fuel storage	15 Oil well/Gas well
3 Watertight sewer lines	6 Seepage pit	9 Feedyard	12 Fertilizer storage	16 Other (specify below)
			13 Insecticide storage	Old well

Direction from well? South How many feet? 35

FROM	TO	LITHOLOGIC LOG	FROM	TO	PLUGGING INTERVALS
0	4	Topsoil			
4	6	Clay, brown			
6	8	Clay, tan			
8	29	Sand and gravel, fine to coarse			
29	34	Clay, green, gray			
34	37	Clay, brown			
37	38	Clay, white with caliche			
38	50	Sand and gravel, fine to coarse			

7 CONTRACTOR'S OR LANDOWNER'S CERTIFICATION: This water well was (1) constructed, (2) reconstructed, or (3) plugged under my jurisdiction and was completed on (mo/day/year) 10/13/05 and this record is true to the best of my knowledge and belief. Kansas Water Well Contractor's License No 185 This Water Well Record was completed on (mo/day/yr) 10/19/05 under the business name of Clarke Well & Equipment, Inc. by (signature) *Clarke Well & Equipment*