

WATER WELL RECORD


Form WWC-5

Division of Water Resources App. No.

1 LOCATION OF WATER WELL: County: RICE Fraction SW 1/4 SW 1/4 SW 1/4 NE 1/4 Section Number 21 Township No. T 21 S Range Number R 8 [] E [X] W

Street/Rural Address of Well Location; if unknown, distance & direction from nearest town or intersection: If at owner's address, check here []. 124 N. Broadway, Sterling, KS Global Positioning System (GPS) information: Latitude: 38.21058 Longitude: 98.20062

2 WATER WELL OWNER: KDHE(Former Car Dealership) RR#, Street Address, Box #: 1000 SW JACKSON STREET City, State, ZIP Code : TOPEKA, KS 66612-1367 Collection Method: [] GPS unit [] Digital Map/Photo [] Topographic Map [X] Land Survey

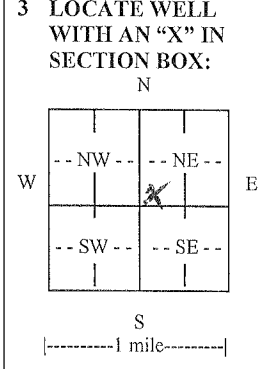

3 LOCATE WELL WITH AN "X" IN SECTION BOX: 4 DEPTH OF COMPLETED WELL 17.0 ft. Depth(s) Groundwater Encountered (1) ~6' (2) (3) WELL'S STATIC WATER LEVEL... Pump test data: Well water was... EST. YIELD... Bore Hole Diameter... WELL WATER TO BE USED AS: [] Public water supply [] Geothermal [X] Injection well [] Domestic [] Feedlot [] Oil field water supply [] Dewatering [] Other (Specify below) [] Irrigation [] Industrial [] Domestic-lawn & garden [] Monitoring well OxyvaenInjection14... Was a chemical/bacteriological sample submitted to Department? [] Yes [X] No

5 TYPE OF CASING USED: [] Steel [X] PVC [] Other CASING JOINTS: [] Glued [] Clamped [] Welded [X] Threaded Casing diameter .1" in. to ... Diameter ... in. to ... Diameter ... in. to ... Casing height above land surface -1.08 in., Weight ... lbs./ft., Wall thickness or gauge No. Sch. 40 PVC TYPE OF SCREEN OR PERFORATION MATERIAL: [] Steel [] Stainless Steel [X] PVC [] Other (Specify) [] Brass [] Galvanized Steel [] None used (open hole) SCREEN OR PERFORATION OPENINGS ARE: [] Continuous slot [X] Mill slot [] Gauze wrapped [] Torch cut [] Drilled holes [] None (open hole) [] Louvered shutter [] Key punched [] Wire wrapped [] Saw cut [] Other (specify) SCREEN-PERFORATED INTERVALS: From .15 ft. to .16 ft., From ... ft. to ... ft. GRAVEL PACK INTERVALS: From .13 ft. to .17 ft., From ... ft. to ... ft.

6 GROUT MATERIAL: [] Neat cement [] Cement grout [X] Bentonite [] Other Grout Intervals: From .1 ft. to .13 ft., From ... ft. to ... ft., From ... ft. to ... ft. What is the nearest source of possible contamination: [] Septic tank [] Lateral lines [] Pit privy [] Livestock pens [] Insecticide storage [X] Other (specify below) [] Sewer lines [] Cesspool [] Sewage lagoon [] Fuel storage [] Abandoned water well [] Watertight sewer lines [] Seepage pit [] Feedyard [] Fertilizer storage [] Oil well/gas well [] Lust Site Direction from well ... Distance from well ...

Table with columns: FROM, TO, LITHOLOGIC LOG, FROM, TO, LITHO. LOG (cont.) or PLUGGING INTERVALS. Rows: 0-1 Asphalt, 1-6 Clay, silty, 6-17 Sand, very fine to fine, OIP14

7 CONTRACTOR'S OR LANDOWNER'S CERTIFICATION: This water well was [X] constructed, [] reconstructed, or [] plugged under my jurisdiction and was completed on (mo/day/year) 06/29/2011... and this record is true to the best of my knowledge and belief. Kansas Water Well Contractor's License No. 594... This Water Well Record was completed on (mo/day/year) 010/05/2011... under the business name of Coranco Great Plains, Inc. by (signature) [Signature]

INSTRUCTIONS: Use typewriter or ball point pen. PLEASE PRESS FIRMLY and PRINT clearly. Please fill in blanks and check the correct answers. Send three copies (white, blue, pink) to Kansas Department of Health and Environment, Bureau of Water, Geology Section, 1000 SW Jackson St., Suite 420, Topeka, Kansas 66612-1367. Telephone 785-296-5522. Send one copy to WATER WELL OWNER and retain one for your records. Include fee of \$5.00 for each constructed well. Visit us at http://www.kdheks.gov/waterwell/index.html.