

MW-15

WATER WELL PLUGGING RECORD Form WWC-5P KSA 82a-1212 ID NO.

1 LOCATION OF WATER WELL: County: Rice Fraction: SE 1/4 SE 1/4 SE 1/4 NW 1/4 Section Number: 21 Township Number: T 21 S Range Number: 8 E W

Street/Rural Address of Well Location; if unknown, distance & direction from nearest town or intersection: If at owner's address, check here 101 N. Broadway Sterling KS


Global Positioning Systems (GPS) information:

Latitude: 38.2101 (in decimal degrees) Longitude: -98.2070 (in decimal degrees) Elevation: 1640 Datum: WGS84, NAD83, NAD27 Collection Method:

2 WATER WELL OWNER: Phillips Lb RR#, St. Address, Box #: 1604-02 Phillips Bldg. City, State ZIP Code: Bartlesville OK 74003

GPS unit (Make/Model): Garmin etrek Digital Map/Photo, Topographic Map, Land Survey Est. Accuracy: 3-5 m

3 MARK WELL'S LOCATION WITH AN "X" IN SECTION BOX:

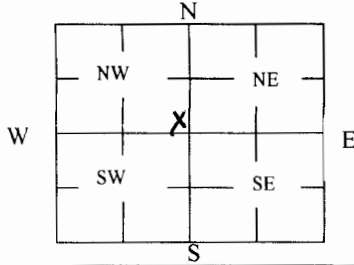

4 DEPTH OF WELL 13 ft.

WELL'S STATIC WATER LEVEL \_\_\_\_\_ ft

WELL WAS USED AS:

- Domestic, Irrigation, Feedlot, Industrial, Public Water Supply, Oil Field Water Supply, Domestic (Lawn & Garden), Air Conditioning, Dewatering, Monitoring, Injection Well, Other

Was a chemical/bacteriological sample submitted to Department? Yes No

5 TYPE OF BLANK CASING USED:

- Steel, PVC, RMP (SR), ABS, Wrought, Asbestos-Cement, Fiberglass, Concrete Tile, Other (Specify below)

Blank casing diameter 2 in. Was casing pulled? Yes No If yes, how much all Casing height above or below land surface -6 in.

6 GROUT PLUG MATERIAL: Neat cement, Cement grout, Bentonite, Other

Grout Plug Intervals: From 3 ft. to 13 ft., From - ft. to - ft., From - to - ft.

What is the nearest source of possible contamination:

- Septic tank, Sewer lines, Watertight sewer lines, Lateral lines, Cess pool, Seepage pit, Pit privy, Sewage lagoon, Feedyard, Livestock pens, Fuel Storage, Fertilizer storage, Insecticide storage, Abandoned water well, Oil well/Gas well, Other (specify below)

Table with 6 columns: FROM, TO, PLUGGING MATERIALS, FROM, TO, PLUGGING MATERIALS. Rows include 0-3 Top Soil and 3-13 Bentonite.

7 CONTRACTOR'S OR LANDOWNER'S CERTIFICATION: This water well was plugged under my jurisdiction and was completed on (mo/day/year) 03/07/2013 and this record is true to the best of my knowledge and belief. Kansas Water Well Contractor's License No. 710. This Water Well Record was completed on (mo/day/year) 3/25/13 under the business name of Below Ground Surface, Inc. by (signature) [Signature]

INSTRUCTIONS: Use typewriter or ballpoint pen. Please press firmly and print clearly. Please fill in blanks, underline or circle the correct answers. Send top three copies to Kansas Department of Health and Environment, Bureau of Water, Geology Section, 1000 SW Jackson St., Ste. 420, Topeka, Kansas 66612-1367. Telephone: 785/296-5524. Send one to Water Well Owner and retain one for your records. Visit us at http://www.kdheks.gov/waterwell/index.html.

Check one: White Copy Blue Copy Pink Copy