

MW-25


WATER WELL PLUGGING RECORD Form WWC-5P KSA 82a-1212 ID NO. [ ]

1 LOCATION OF WATER WELL: Fraction SE 1/4 SE 1/4 SE 1/4 NW 1/4 Section Number 21 Township Number T 21 S Range Number 8 E W

Street/Rural Address of Well Location: if unknown, distance & direction from nearest town or intersection: If at owner's address, check here [ ] 101 N. Broadway Sterling KS

Global Positioning Systems (GPS) information: Latitude: 38.2101 (in decimal degrees) Longitude: -98.2071 (in decimal degrees) Elevation: 1640 Datum: [ ] WGS84, [ ] NAD83, [ ] NAD27 Collection Method: [ ] GPS unit (Make/Model): Garmin etrex [ ] Digital Map/Photo, [ ] Topographic Map, [ ] Land Survey Est. Accuracy: [ ] < 3 m, [X] 3-5 m, [ ] 5-15 m, [ ] > 15 m

2 WATER WELL OWNER: Phillips 66 RR#, St. Address, Box #: 1604-02 Phillips Bldg. City, State ZIP Code: Bartlesville OK 74003

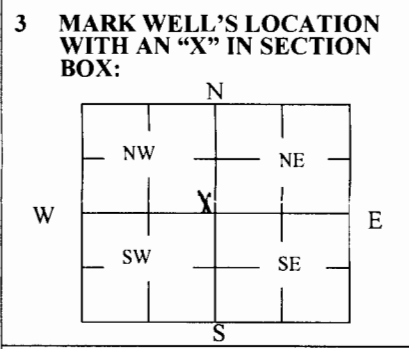

4 DEPTH OF WELL 13 ft. WELL'S STATIC WATER LEVEL \_\_\_\_\_ ft. WELL WAS USED AS: [ ] Domestic [ ] Public Water Supply [ ] Dewatering [ ] Irrigation [ ] Oil Field Water Supply [ ] Monitoring [ ] Feedlot [ ] Domestic (Lawn & Garden) [ ] Injection Well [ ] Industrial [ ] Air Conditioning [ ] Other \_\_\_\_\_ Was a chemical/bacteriological sample submitted to Department? Yes [ ] No [X]

5 TYPE OF BLANK CASING USED: [X] Steel [ ] RMP (SR) [ ] Wrought [ ] Fiberglass [ ] Other (Specify below) [ ] PVC [ ] ABS [ ] Asbestos-Cement [ ] Concrete Tile Blank casing diameter 2 in. Was casing pulled? Yes [X] No [ ] If yes, how much 9 ft. Casing height above or below land surface -6 in.

6 GROUT PLUG MATERIAL: [ ] Neat cement [ ] Cement grout [X] Bentonite [ ] Other \_\_\_\_\_ Grout Plug Intervals: From 3 ft. to 13 ft., From - ft. to - ft., From - to - ft. What is the nearest source of possible contamination: [ ] Septic tank [ ] Seepage pit [X] Fuel Storage [ ] Other (specify below) [ ] Sewer lines [ ] Pit privy [ ] Fertilizer storage [ ] Watertight sewer lines [ ] Sewage lagoon [ ] Insecticide storage [ ] Lateral lines [ ] Feedyard [ ] Abandoned water well [ ] Direction from well? \_\_\_\_\_ [ ] Cess pool [ ] Livestock pens [ ] Oil well/Gas well [ ] How many feet? \_\_\_\_\_

Table with 6 columns: FROM, TO, PLUGGING MATERIALS, FROM, TO, PLUGGING MATERIALS. Row 1: 0, 3, Top soil, empty, empty, empty. Row 2: 3, 13, Bentonite, empty, empty, empty.

7 CONTRACTOR'S OR LANDOWNER'S CERTIFICATION: This water well was plugged under my jurisdiction and was completed on (mo/day/year) 03/07/2013 and this record is true to the best of my knowledge and belief. Kansas Water Well Contractor's License No. 710. This Water Well Record was completed on (mo/day/year) 3/25/13 under the business name of Below Ground Surface, Inc. by (signature) [Signature]

INSTRUCTIONS: Use typewriter or ballpoint pen. Please press firmly and print clearly. Please fill in blanks, underline or circle the correct answers. Send top three copies to Kansas Department of Health and Environment, Bureau of Water, Geology Section, 1000 SW Jackson St., Ste. 420, Topeka, Kansas 66612-1367. Telephone: 785/296-5524. Send one to Water Well Owner and retain one for your records. Visit us at http://www.kdheks.gov/waterwell/index.html.

Check one: [ ] White Copy [ ] Blue Copy [ ] Pink Copy