

WATER WELL RECORD

Form WWC-5

Division of Water Resources App. No.


12,817

1 LOCATION OF WATER WELL: County: Rice	Fraction SE ¼ SE ¼ NW ¼ SE ¼	Section Number 23	Township No. T 21 S	Range Number R 8 <input type="checkbox"/> E <input checked="" type="checkbox"/> W
--	---------------------------------	----------------------	------------------------	--

Street/Rural Address of Well Location; if unknown, distance & direction from nearest town or intersection: If at owner's address, check here .
From Nickerson N. 5 mile to Ave. V 4 W. 3/4 S. WSR

Global Positioning System (GPS) information:
Latitude: .38.20656..... (in decimal degrees)
Longitude: 098.16505..... (in decimal degrees)
Elevation: 1618.....
Datum: WGS 84, NAD 83, NAD 27
Collection Method:
 GPS unit (Make/Model: 62S Garmin.....)
 Digital Map/Photo, Topographic Map, Land Survey
Est. Accuracy: <3 m, 3-5 m, 5-15 m, >15 m

2 WATER WELL OWNER: Gary & Joanna Proffitt
RR#, Street Address, Box #: 2470 18th. Road
City, State, ZIP Code : Sterling, Kansas 67579

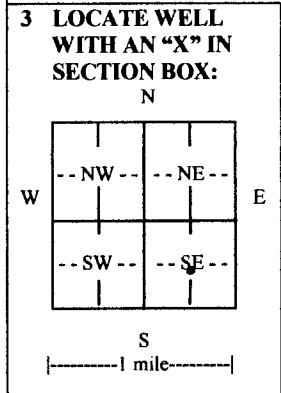

4 DEPTH OF COMPLETED WELL 62..... ft.
Depth(s) Groundwater Encountered (1)..... ft. (2)..... ft. (3)..... ft.
WELL'S STATIC WATER LEVEL 12..... ft. below land surface measured on mo/day/yr. 4-12-2013.....
Pump test data: Well water was.....ft. after..... hours pumping..... gpm
EST. YIELD.....gpm. Well water was.....ft. after..... hours pumping..... gpm
Bore Hole Diameter 30.....in. to 62.....ft., and.....in. to.....ft.
WELL WATER TO BE USED AS: Public water supply Geothermal Injection well
 Domestic Feedlot Oil field water supply Dewatering Other (Specify below)
 Irrigation Industrial Domestic-lawn & garden Monitoring well
Was a chemical/bacteriological sample submitted to Department? Yes No
If yes, mo/day/yr sample was submitted.....
Water well disinfected? Yes No

5 TYPE OF CASING USED: Steel PVC Other
CASING JOINTS: Glued Clamped Welded Threaded
Casing diameter 16..... in. to 42..... ft., Diameter in. to ft., Diameter in. to ft.
Casing height above land surface 24..... in., Weight SCH 40.....lbs./ft., Wall thickness or gauge No. 500
TYPE OF SCREEN OR PERFORATION MATERIAL:
 Steel Stainless Steel PVC Other (Specify)
 Brass Galvanized Steel None used (open hole)
SCREEN OR PERFORATION OPENINGS ARE:
 Continuous slot Mill slot Gauze wrapped Torch cut Drilled holes None (open hole)
 Louvered shutter Key punched Wire wrapped Saw cut Other (specify)
SCREEN-PERFORATED INTERVALS: From 42..... ft. to 62..... ft., From ft. to ft.
From..... ft. to ft., From ft. to ft.
GRAVEL PACK INTERVALS: From 62..... ft. to 20..... ft., From ft. to ft.
From..... ft. to ft., From ft. to ft.

6 GROUT MATERIAL: Neat cement Cement grout Bentonite Other
Grout Intervals: From 20..... ft. to 0..... ft., From ft. to ft., From ft. to ft.
What is the nearest source of possible contamination:
 Septic tank Lateral lines Pit privy Livestock pens Insecticide storage Other (specify below)
 Sewer lines Cesspool Sewage lagoon Fuel storage Abandoned water well
 Watertight sewer lines Seepage pit Feedyard Fertilizer storage Oil well/gas well Old well
Direction from well East..... Distance from well 35'.....

FROM	TO	LITHOLOGIC LOG	FROM	TO	LITHO. LOG (cont.) or PLUGGING INTERVALS
0	3	Top soil			
3	9	Brown clay			
9	12	Brown clay and sand mix			
12	34	Small and medium fine sand			
34	35	Small sand with tan clay			
35	45	Medium to small fine sand			
45	47	Medium to small sand w/large rock			
47	60	Small with fine sand			
60	62	Tan clay			

7 CONTRACTOR'S OR LANDOWNER'S CERTIFICATION: This water well was constructed, reconstructed, or plugged under my jurisdiction and was completed on (mo/day/year) 4-12-2013..... and this record is true to the best of my knowledge and belief.
Kansas Water Well Contractor's License No. 134..... This Water Well Record was completed on (mo/day/year) 4-17-2013.....
under the business name of Rosencrantz-Bemis Enterprises..... by (signature) Daniel A. Odum

INSTRUCTIONS: Use typewriter or ball point pen. PLEASE PRESS FIRMLY and PRINT clearly. Please fill in blanks and check the correct answers. Send three copies (white, blue, pink) to Kansas Department of Health and Environment, Bureau of Water, Geology Section, 1000 SW Jackson St., Suite 420, Topeka, Kansas 66612-1367. Telephone 785-296-5524. Send one copy to WATER WELL OWNER and retain one for your records. Include fee of \$5.00 for each constructed well. Visit us at <http://www.kdheks.gov/waterwell/index.html>.