







PM COPY

UTILITY LOCATE

LEGEND

- SB-1 - Proposed Soil Borings to Average Vadose Zone (8.0 feet)
- SB-2 - Proposed Geotech Soil Boring to 11 feet
- MW-D - Proposed Monitoring Wells To 15 feet
- MW2 - Monitoring Well Location
- VDBW1 - Vapor Observation Well Location
- IWA - Injection Well Location
- IWA - Soil Borings June 2007
- OI9 - Oxygen Injection Well
- Junction Box
- Trench Location
- NATURAL GAS (3-5 foot depth)
- STORM DRAIN / SEWER (4-6 foot depth)
- OVERHEAD ELECTRIC (20 foot height)
- WATER (4-5 foot depth)
- FIBER OPTICS (3-5 foot depth)
- PROPERTY LINE
- EXISTING UNDERGROUND STORAGE TANK (UST) SYSTEM COMPONENTS
- FORMER UNDERGROUND STORAGE TANK (UST)
- PLUGGED MONITORING WELLS
- ESTIMATED GROUNDWATER FLOW DIRECTION

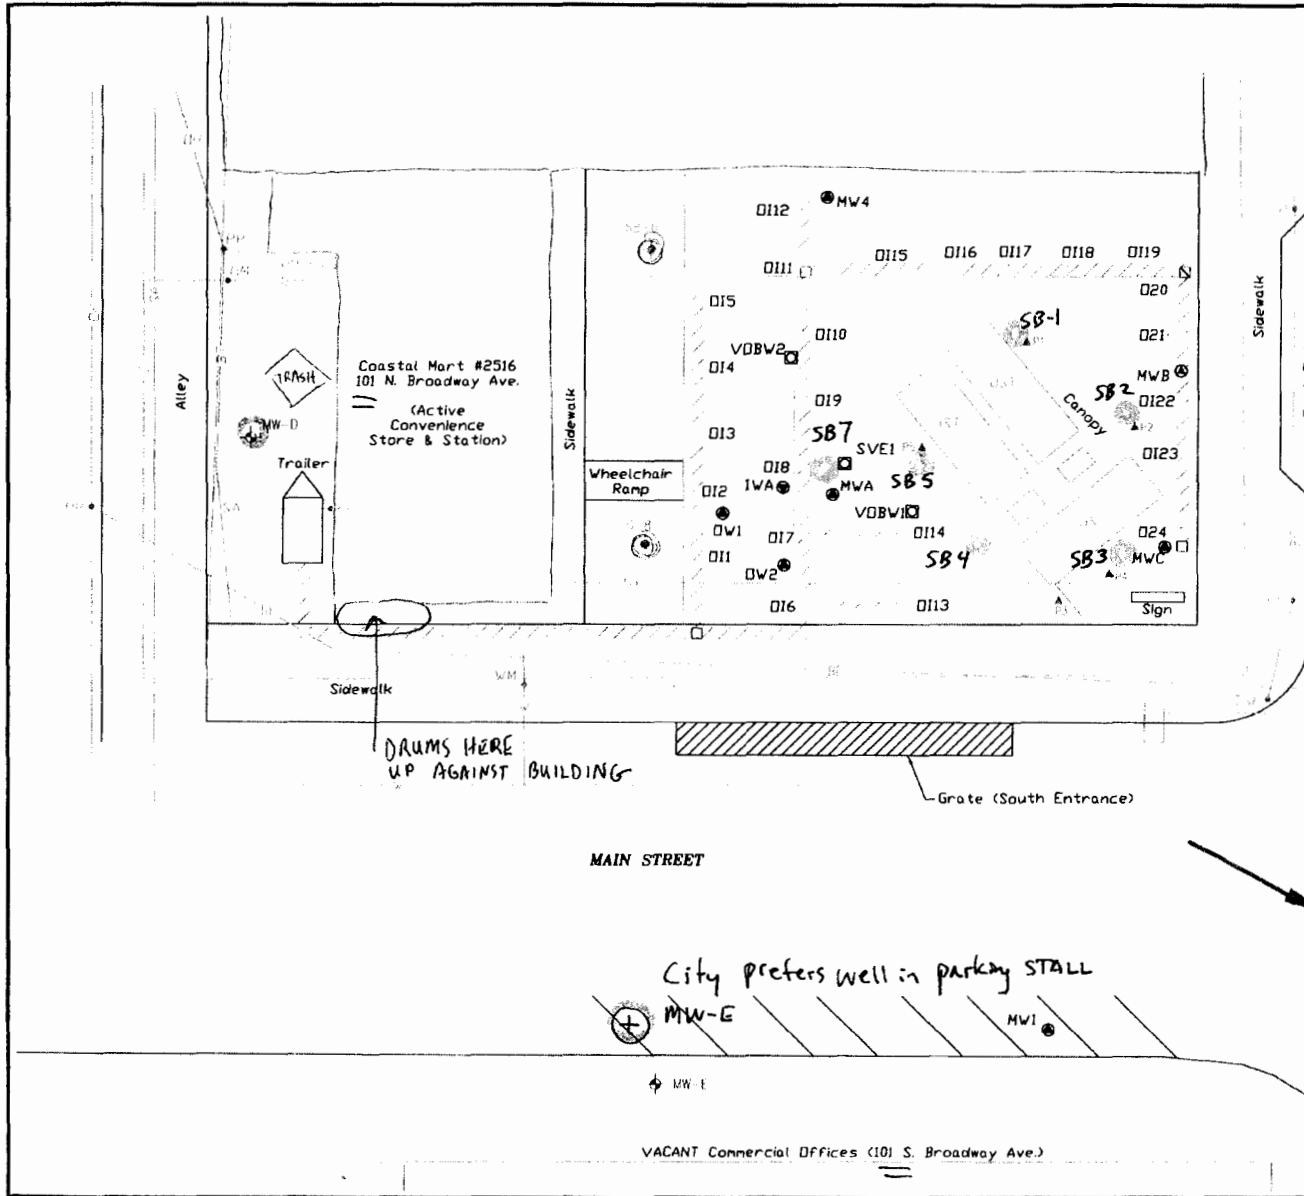

1.0	 <b>Cardno</b> <b>ATC</b> Shaping the Future	
<b>DETAILED SITE MAP</b> U5-080-13052 COASTAL MART #2516 101 N. BROADWAY STERLING, KANSAS		
PROJECT NUMBER: 17.75000.4232	DOCUMENT: KRBCA	DRAWN BY: MY 03/19/15
FILE PATH: S278-F1.DWG		CHECKED BY: JC 03/23/15