


3

WATER WELL PLUGGING RECORD Form WWC-5P KSA 82a-1212 ID NO. [ ]

1 LOCATION OF WATER WELL: County: Rice Fraction NW 1/4 S 1/4 SW 1/4 NE 1/4 Section Number 9 Township Number T 21 S Range Number 8 [ ] E [X] W

Street/Rural Address of Well Location; if unknown, distance & direction from nearest town or intersection: If at owner's address, check here [ ] 2040 State Rd. 14 Sterling, Kansas 67579 Global Positioning Systems (GPS) information: Latitude: 38.24014 (in decimal degrees) Longitude: 098.20599 (in decimal degrees) Elevation: 1631 Horizontal Datum: [ ] WGS84, [ ] NAD83, [X] NAD27 Collection Method:

2 WATER WELL OWNER: KDOT - Eisenhower St. Office RR#, St. Address, Box #: 700 SW Harrison St. 14th floor City, State ZIP Code: Topeka, Kansas 66603 [X] GPS unit (Make/Model: Garmin 62S [ ] Digital Map/Photo, [X] Topographic Map, [ ] Land Survey Est. Accuracy: [ ] < 3 m, [X] 3-5 m, [ ] 5-15 m, [ ] > 15 m

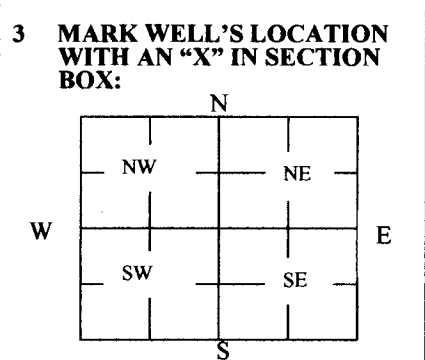

4 DEPTH OF WELL 28 ft. WELL'S STATIC WATER LEVEL 12 ft. WELL WAS USED AS: [X] Domestic [ ] Irrigation [ ] Feedlot [ ] Industrial [ ] Public Water Supply [ ] Oil Field Water Supply [ ] Domestic (Lawn & Garden) [ ] Air Conditioning [ ] Dewatering [ ] Monitoring [ ] Injection Well [ ] Other Was a chemical/bacteriological sample submitted to Department? Yes [ ] No [X]

5 TYPE OF BLANK CASING USED: [ ] Steel [ ] PVC [ ] RMP (SR) [ ] ABS [ ] Wrought [ ] Asbestos-Cement [ ] Fiberglass [ ] Concrete Tile [X] Other (Specify below) Tin Blank casing diameter 6 in. Was casing pulled? Yes [ ] No [X] If yes, how much Casing height above or below land surface 36 in.

6 GROUT PLUG MATERIAL: [ ] Neat cement [ ] Cement grout [X] Bentonite [ ] Other Grout Plug Intervals: From 0 ft. to 28 ft., From ft. to ft., From ft. to ft. What is the nearest source of possible contamination: [ ] Septic tank [ ] Sewer lines [ ] Watertight sewer lines [ ] Lateral lines [ ] Cess pool [ ] Seepage pit [ ] Pit privy [ ] Sewage lagoon [ ] Feedyard [ ] Livestock pens [ ] Fuel storage [ ] Fertilizer storage [ ] Insecticide storage [ ] Abandoned water well [ ] Oil well/Gas well [X] Other (specify below) N/A Direction from well? How many feet?

Table with 6 columns: FROM, TO, PLUGGING MATERIALS, FROM, TO, PLUGGING MATERIALS. Row 1: 0, 28, Bentonite, , , , ,

7 CONTRACTOR'S OR LANDOWNER'S CERTIFICATION: This water well was plugged under my jurisdiction and was completed on (mo/day/year) 1/20/2017 and this record is true to the best of my knowledge and belief. Kansas Water Well Contractor's License No. 134. This Water Well Record was completed on (mo/day/year) 1/24/2017 under the business name of Rosencrantz-Bemis Ent. by (signature) [Signature]

Send one white copy to Kansas Department of Health & Environment, Geology Section, 1000 SW Jackson Street, Ste. 420, Topeka, KS 66612-1367. Send one copy to WATER WELL OWNER and retain one for your records. Visit us at http://www.kdheks.gov/waterwell/index.html Telephone 785-296-5524.