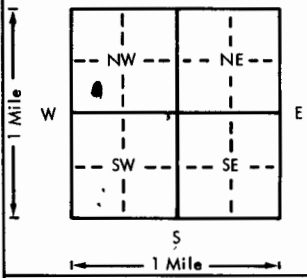


USE TYPEWRITER OR BALL POINT PEN—PRESS FIRMLY, PRINT CLEARLY.

WATER WELL RECORD  
KSA 82a-1201-1215

Kansas Department of Health and Environment—Division of Environment (Water well Contractors)  
Topeka, Kansas 66620

1. Location of well:	County: <u>Rice</u>	Fraction: <u>1/4</u>	Section number: <u>19</u>	Township number: <u>21 S</u>	Range number: <u>8 W</u>
2. Distance and direction from nearest town or city: <u>3 West Sterling</u> Street address of well location if in city:			3. Owner of well: <u>Stirling Bulling Co.</u> R.R. or street: City, state, zip code: <u>Stirling Kans.</u>		
4. Locate with "X" in section below: N W E S 1 Mile Sketch map: 			6. Bore hole dia. <u>8</u> in. Completion date Well depth <u>60</u> ft. <u>6-24-76</u>		
5. Type and color of material			7. <input checked="" type="checkbox"/> Cable tool <input checked="" type="checkbox"/> Rotary <input type="checkbox"/> Driven <input type="checkbox"/> Dug <input type="checkbox"/> Hollow rod <input type="checkbox"/> Jetted <input type="checkbox"/> Bored <input type="checkbox"/> Reverse rotary		
			8. Use: <input type="checkbox"/> Domestic <input type="checkbox"/> Public supply <input type="checkbox"/> Industry <input type="checkbox"/> Irrigation <input type="checkbox"/> Air conditioning <input type="checkbox"/> Stock <input type="checkbox"/> Lawn <input checked="" type="checkbox"/> Oil field water <input type="checkbox"/> Other		
From			9. Casing: Material <u>Fluted</u> Height: Above or below Threaded <input type="checkbox"/> Welded <input checked="" type="checkbox"/> Surface <u>1 1/2</u> in. RMP <input type="checkbox"/> PVC <input checked="" type="checkbox"/> Weight <u>28.5</u> lbs./ft. Dia. <u>5</u> in. to <u>60</u> ft. depth Wall Thickness: inches or Dia. <u>  </u> in. to <u>  </u> ft. depth gage No. <u>265</u>		
			10. Screens: Manufacturer's name <u>Meyer</u> Type <u>Slot</u> Dia. <u>5</u> Slot/gauze <u>1/8</u> Length <u>20</u> Set between <u>8</u> ft. and <u>60</u> ft. <u>  </u> ft. and <u>  </u> ft. Gravel pack? <input checked="" type="checkbox"/> Size range of material <u>5-9</u>		
Fine sand			11. Static water level: <u>18</u> ft. below land surface Date <u>6-24-76</u> mo./day/yr.		
Clay			12. Pumping level below land surfaces: <u>28</u> ft. after <u>2</u> hrs. pumping <u>80</u> g.p.m. <u>  </u> ft. after <u>  </u> hrs. pumping <u>  </u> g.p.m. Estimated maximum yield <u>150</u> g.p.m.		
Fine sand			13. Water sample submitted: <u>  </u> mo./day/yr. Yes <input checked="" type="checkbox"/> No <input type="checkbox"/> Date <u>  </u>		
Gravel			14. Well head completion: <input type="checkbox"/> Pitless adapter <u>12</u> inches above grade		
			15. Well grouted? <input checked="" type="checkbox"/> With: <input type="checkbox"/> Neat cement <input checked="" type="checkbox"/> Bentonite <input type="checkbox"/> Concrete Depth: From <u>0</u> ft. to <u>20</u> ft.		
			16. Nearest source of possible contamination: ft. <u>  </u> Direction <u>  </u> Type <u>  </u> Well disinfected upon completion? <input type="checkbox"/> Yes <input type="checkbox"/> No		
			17. Pump: <input checked="" type="checkbox"/> Not installed Manufacturer's name <u>  </u> Model number <u>  </u> HP <u>  </u> Volts <u>  </u> Length of drop pipe <u>  </u> ft. capacity <u>  </u> g.p.m. Type: <input type="checkbox"/> Submersible <input type="checkbox"/> Turbine <input type="checkbox"/> Jet <input type="checkbox"/> Reciprocating <input type="checkbox"/> Centrifugal <input type="checkbox"/> Other		
(Use a second sheet if needed)					
18. Elevation:  Topography: <input type="checkbox"/> Hill <input type="checkbox"/> Slope <input type="checkbox"/> Upland <input type="checkbox"/> Valley		19. Remarks:		20. Water well contractor's certification: This well was drilled under my jurisdiction, and this report is true to the best of my knowledge and belief. <u>Meyer's Water Well Service</u> Business name <u>  </u> License No. <u>  </u> Address <u>  </u> Signed <u>  </u> Date <u>  </u> Authorized representative	

Forward the white, blue and pink copies to the Department of Health and Environment

Form WWC-5