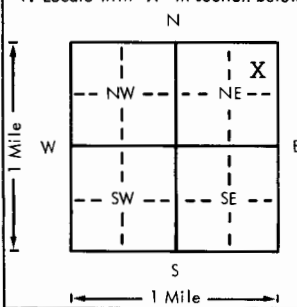


USE TYPEWRITER OR BALL POINT PEN—PRESS FIRMLY, PRINT CLEARLY.

WATER WELL RECORD
KSA 82a-1201-1215

Kansas Department of Health and Environment—Division of Environment
(Water well Contractors)
Topeka, Kansas 66620

1. Location of well:		County Rice	Fraction 1/4NE 1/4 NE 1/4	Section number 21	Township number T 21 S R 8	Range number EW
2. Distance and direction from nearest town or city: Street address of well location if in city: In Sterling - Address Unknown				3. Owner of well: Glen Risley R.R. or street: Rural Route City, state, zip code: Sterling, KS 67579		
4. Locate with "X" in section below: Sketch map: 				6. Bore hole dia. 4 1/2 in. Completion date 10-18-78 Well depth 30 ft.		
5. Type and color of material				7. <input checked="" type="checkbox"/> Cable tool <input checked="" type="checkbox"/> Rotary <input type="checkbox"/> Driven <input type="checkbox"/> Dug <input type="checkbox"/> Hollow rod <input type="checkbox"/> Jetted <input type="checkbox"/> Bored <input type="checkbox"/> Reverse rotary		
				8. Use: <input type="checkbox"/> Domestic <input type="checkbox"/> Public supply <input type="checkbox"/> Industry <input type="checkbox"/> Irrigation <input type="checkbox"/> Air conditioning <input type="checkbox"/> Stock <input checked="" type="checkbox"/> Lawn <input type="checkbox"/> Oil field water <input type="checkbox"/> Other		
From To				9. Casing: Material Styrene Height: Above or below Threaded <input type="checkbox"/> Welded <input checked="" type="checkbox"/> Surface 12 in. RMP <input type="checkbox"/> PVC <input type="checkbox"/> Weight 1.5 lbs./ft. Dia. 5 in. to 20 ft. depth Wall Thickness: inches or Dia. <input type="checkbox"/> in. to <input type="checkbox"/> ft. depth gage No. .200		
				10. Screen: Manufacturer's name Jess & Lowell Type Styrene 200 Dia. 5" slat gauze 1/8" Length 10' Set between 20 ft. and 30 ft. ft. and <input type="checkbox"/> ft. Gravel pack? Yes Size range of material 3/8-200		
Top soil				0	5	11. Static water level: 7 ft. below land surface Date 10-18-78 mo./day/yr.
Sand & gravel				5	17	12. Pumping level below land surfaces: Not Checked ____ ft. after ____ hrs. pumping ____ g.p.m. ____ ft. after ____ hrs. pumping ____ g.p.m. Estimated maximum yield ____ g.p.m.
Blue clay				17	19	13. Water sample submitted: mo./day/yr. <input type="checkbox"/> Yes <input checked="" type="checkbox"/> No Date _____
Sand & gravel				19	30	14. Well head completion: <input type="checkbox"/> Pitless adapter 12 Inches above grade
(Use a second sheet if needed)						15. Well grouted? Yes With: <input checked="" type="checkbox"/> Neat cement <input type="checkbox"/> Bentonite <input type="checkbox"/> Concrete Depth: From 0 ft. to 10 ft.
18. Elevation:				16. Nearest source of possible contamination: FIELD ft. _____ Direction _____ Type _____ Well disinfected upon completion? <input checked="" type="checkbox"/> Yes <input type="checkbox"/> No		
				17. Pump: <input checked="" type="checkbox"/> Not installed Manufacturer's name _____ Model number _____ HP _____ Volts _____ Length of drop pipe _____ ft. capacity _____ g.p.m. Type: <input type="checkbox"/> Submersible <input type="checkbox"/> Turbine <input type="checkbox"/> Jet <input type="checkbox"/> Reciprocating <input type="checkbox"/> Centrifugal <input type="checkbox"/> Other		
19. Remarks:				20. Water well contractor's certification: This well was drilled under my jurisdiction and this report is true to the best of my knowledge and belief. Clarke Well & Eq., Inc. 185 Business name License No. 87530 Address Great Bend, KS Signed [Signature] Date 10-20-78 Authorized representative		
Topography: <input type="checkbox"/> Hill <input type="checkbox"/> Slope <input type="checkbox"/> Upland <input type="checkbox"/> Valley						

21-80-21 NE NE