


1 LOCATION OF WATER WELL: Fraction SW 1/4 NW 1/4 SE 1/4 Section Number 21 Township Number T 21 S Range Number R 8 (NW)  
 County: RICE

Distance and direction from nearest town or city street address of well if located within city?  
STERLING COOP 314 S. BROADWAY STERLING, KANSAS

2 WATER WELL OWNER: JEFF BENNETT  
 RR#, St. Address, Box #: 314 S. BROADWAY  
 City, State, ZIP Code: STERLING, KANSAS 67579  
 Board of Agriculture, Division of Water Resources  
 Application Number:         

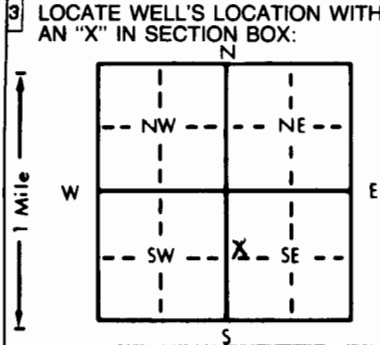

4 DEPTH OF COMPLETED WELL: 15 ft. ELEVATION:          ft.  
 Depth(s) Groundwater Encountered 1. 7.5 ft. 2.          ft. 3.          ft.  
 WELL'S STATIC WATER LEVEL 8.37 ft. below land surface measured on mo/day/yr 2-23-94  
 Pump test data: Well water was          ft. after          hours pumping          gpm  
 Est. Yield          gpm: Well water was          ft. after          hours pumping          gpm  
 Bore Hole Diameter: 7.25 in. to 15 ft., and          in. to          ft.  
 WELL WATER TO BE USED AS:  
 5 Public water supply      8 Air conditioning      11 Injection well  
 1 Domestic      3 Feedlot      6 Oil field water supply      9 Dewatering      12 Other (Specify below)  
 2 Irrigation      4 Industrial      7 Lawn and garden only      10 Monitoring well  
 Was a chemical/bacteriological sample submitted to Department? Yes          No X; If yes, mo/day/yr sample was submitted           
 Water Well Disinfected? Yes          No X

5 TYPE OF BLANK CASING USED:  
 1 Steel      3 RMP (SR)      5 Wrought iron      8 Concrete tile      CASING JOINTS: Glued          Clamped           
2 PVC      4 ABS      6 Asbestos-Cement      9 Other (specify below)      Welded           
 7 Fiberglass      Threaded X  
 Blank casing diameter 2 in. to 4.8 ft., Dia          in. to          ft., Dia          in. to          ft.  
 Casing height above land surface 24 in., weight 5CH 40 lbs./ft. Wall thickness or gauge No.           
 TYPE OF SCREEN OR PERFORATION MATERIAL:  
 1 Steel      3 Stainless steel      5 Fiberglass      7 PVC      10 Asbestos-cement  
 2 Brass      4 Galvanized steel      6 Concrete tile      8 RMP (SR)      11 Other (specify)           
 9 ABS      12 None used (open hole)  
 SCREEN OR PERFORATION OPENINGS ARE:  
 1 Continuous slot      3 Mill slot      5 Gauzed wrapped      8 Saw cut      11 None (open hole)  
 2 Louvered shutter      4 Key punched      6 Wire wrapped      9 Drilled holes  
 7 Torch cut      10 Other (specify)           
 SCREEN-PERFORATED INTERVALS: From 4.8 ft. to 14.8 ft., From          ft. to          ft.  
SAND  
GRAVEL PACK INTERVALS: From 3.8 ft. to 15 ft., From          ft. to          ft.

6 GROUT MATERIAL: 1 Neat cement      2 Cement grout      3 Bentonite      4 Other           
 Grout Intervals: From GL ft. to 1.8 ft., From 1.8 ft. to 3.8 ft., From          ft. to          ft.  
 What is the nearest source of possible contamination:  
 1 Septic tank      4 Lateral lines      7 Pit privy      10 Livestock pens      14 Abandoned water well  
 2 Sewer lines      5 Cess pool      8 Sewage lagoon      11 Fuel storage      15 Oil well/Gas well  
 3 Watertight sewer lines      6 Seepage pit      9 Feedyard      12 Fertilizer storage      16 Other (specify below) CONTAMINATED SITE  
 13 Insecticide storage

Direction from well?          How many feet?         

FROM	TO	LITHOLOGIC LOG	FROM	TO	PLUGGING INTERVALS
<u>GL</u>	<u>3</u>	<u>FILL - GRAVELLY CLAY</u>			
<u>3</u>	<u>4.8</u>	<u>SILTY CLAY</u>			
<u>4.8</u>	<u>15</u>	<u>SAND</u>			
<u>TD</u>	<u>15</u>				

7 CONTRACTOR'S OR LANDOWNER'S CERTIFICATION: This water well was (1) constructed, (2) reconstructed, or (3) plugged under my jurisdiction and was completed on (mo/day/year) 2-22-94 and this record is true to the best of my knowledge and belief. Kansas Water Well Contractor's License No. 479 This Water Well Record was completed on (mo/day/yr) 03-17-94 under the business name of EBBERTS DRILLING by (signature) Gregory Ebberts