

USE TYPEWRITER OR BALL POINT PEN-PRESS FIRMLY, PRINT CLEARLY.

21 8W 28CSW NE
 T R EW sec 1/4 1/4 1/4 No.


WATER WELL RECORD
 KSA 82a-1201-1215

Kansas State Dept. Of Health
 (Water Well Contractors)
 Forbes-Bldg. 740
 Topeka, Kansas 66620

C of SW 1/4 of NE 1/4

1 Location of well: County Pike Township name Sterling Fraction X SE Quarter of NE Section number 28 Town number 21 Range number 8-W

Distance and direction from nearest town or city: 1/2 mile So of Sterling 1/4 East in field 3 Owner of well: Dick Mead
 Street address of well location if in city: Sterling, Kansas 67579

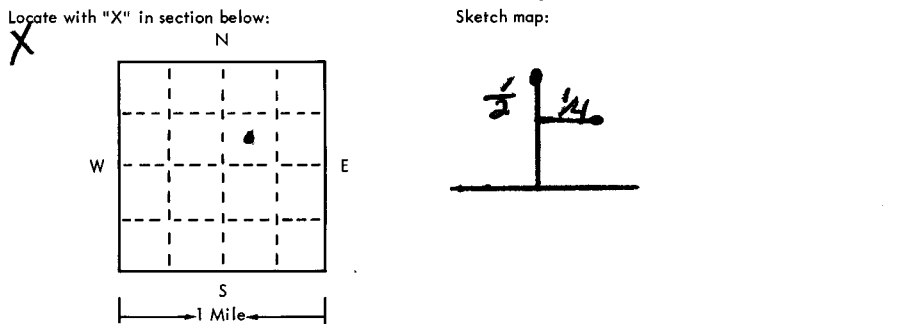

4 Well depth: 52 ft. Date of completion 12/12/78
 Well diameter 26 in.

5 Cable tool Rotary Driven Dug
 Hollow rod Jetted Bored Reverse rotary

6 Use: Domestic Public supply Industry
 Irrigation Air conditioning Commercial
 Test well

7 Casing: Material transite Height: above/below
 Threaded Welded Surface 8 in.
 Diam. 16 in. Weight 30 lbs./ft.
16 in. to 26 ft. depth Drive shoe? Yes No
 in. to ft. depth

2

Type and color of material	From	To
Top soil	0	5
Med. to coarse gravel	5	52
Fine sand	52	60

(use a second sheet if needed)

8 Screen:
 Manufacturer Johnson
 Type SAWED Dia. 16
 Slot/gauze 3/16 Length 26
 Set between 26 ft. and 52 ft.
 Fittings:
 Gravel pack Yes No Size range of material 1/8-1/4

9 Static water level:
7 ft. below land surface Date 12/12/78

10 Pumping level below land surfaces:
28 ft. after 1 hrs. pumping 600 g.p.m.
33 ft. after 2 hrs. pumping 800 g.p.m.
 Estimated maximum yield 950 g.p.m.

11 Water sample submitted:
 Yes No Date _____

12 Well head completion:
 Pitless adapter Inches above grade

13 Well grouted? Yes No
 Neat cement Bentonite concrete
 Depth: From 0 ft. to 10 ft.

14 Nearest source of possible contamination:
 ft. _____ Direction _____ Type _____
 Well disinfected upon completion? Yes No

15 Pump: Not installed
 Manufacturer's name Western Land Roller
 Model number H-10-CA 25 Volts 940
 Length of drop pipe 40 ft. capacity 500 g.p.m.
 Type:
 Submersible Turbine
 Jet Reciprocating
 Centrifugal Other

16 Remarks: elevation

Topography:
 Hill
 Slope
 Upland
 Valley

17 Water well contractor's certification:
 This well was drilled under my jurisdiction and this report is true to the best of my knowledge and belief.
Rosenkrantz-Bemis, Inc.
 Business name License No. 134
 Address 1211 W. 4th Hutchinson, Kans.
 Signed Mike Young Date 12-9-79
 Authorized representative