


1 LOCATION OF WATER WELL:	Fraction	Section Number	Township Number	Range Number
County: <u>Rice</u>	<u>SE 1/4 NE 1/4 SE 1/4</u>	<u>21</u>	<u>T 21 S</u>	<u>R 8W EW</u>

Distance and direction from nearest town or city street address of well if located within city?  
528 E. Main, Sterling, Kansas

2 WATER WELL OWNER: <u>Harold Schmidt</u>	Board of Agriculture, Division of Water Resources
RR#, St. Address, Box # : <u>528 E. Main</u>	Application Number: <u>w94-21</u>
City, State, ZIP Code : <u>Sterling, Kansas 67579</u>	

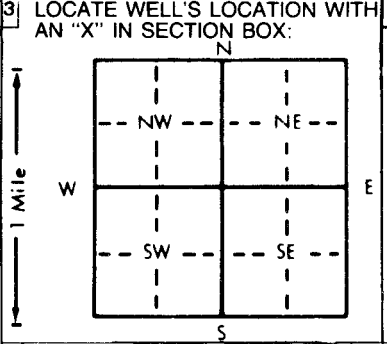

4 DEPTH OF COMPLETED WELL: <u>35</u> ft.	ELEVATION:			
Depth(s) Groundwater Encountered: 1. _____ ft. 2. _____ ft. 3. _____ ft.				
WELL'S STATIC WATER LEVEL: <u>8</u> ft. below land surface measured on mo/day/yr				
Pump test data: Well water was _____ ft. after _____ hours pumping _____ gpm				
Est. Yield _____ gpm: Well water was _____ ft. after _____ hours pumping _____ gpm				
Bore Hole Diameter: <u>10</u> in. to <u>40</u> ft., and _____ in. to _____ ft.				
WELL WATER TO BE USED AS:				
5 Public water supply	8 Air conditioning	11 Injection well		
1 Domestic	3 Feedlot	6 Oil field water supply	9 Dewatering	12 Other (Specify below)
2 Irrigation	4 Industrial	<input checked="" type="checkbox"/> 7 Lawn and garden only	10 Monitoring well	
Was a chemical/bacteriological sample submitted to Department? Yes _____ No <input checked="" type="checkbox"/> _____; If yes, mo/day/yr sample was submitted _____				
Water Well Disinfected? Yes <input checked="" type="checkbox"/> No _____				

5 TYPE OF BLANK CASING USED:	5 Wrought iron	8 Concrete tile	CASING JOINTS: Glued <input checked="" type="checkbox"/> Clamped _____	
1 Steel	3 RMP (SR)	6 Asbestos-Cement	9 Other (specify below)	Welded _____
<input checked="" type="checkbox"/> PVC	4 ABS	7 Fiberglass		Threaded _____
Blank casing diameter: <u>5</u> in. to <u>25</u> ft., Dia _____ in. to _____ ft., Dia _____ in. to _____ ft.				
Casing height above land surface: <u>24</u> in., weight _____ lbs./ft. Wall thickness or gauge No. <u>258</u>				
TYPE OF SCREEN OR PERFORATION MATERIAL:	<input checked="" type="checkbox"/> 7 PVC	10 Asbestos-cement		
1 Steel	3 Stainless steel	5 Fiberglass	8 RMP (SR)	11 Other (specify) _____
2 Brass	4 Galvanized steel	6 Concrete tile	9 ABS	12 None used (open hole)
SCREEN OR PERFORATION OPENINGS ARE:	5 Gauzed wrapped	<input checked="" type="checkbox"/> 8 Saw cut	11 None (open hole)	
1 Continuous slot	3 Mill slot	6 Wire wrapped	9 Drilled holes	
2 Louvered shutter	4 Key punched	7 Torch cut	10 Other (specify) _____	
SCREEN-PERFORATED INTERVALS:	From <u>35</u> ft. to <u>25</u> ft., From _____ ft. to _____ ft.			
	From _____ ft. to _____ ft., From _____ ft. to _____ ft.			
GRAVEL PACK INTERVALS:	From <u>35</u> ft. to <u>20</u> ft., From _____ ft. to _____ ft.			
	From _____ ft. to _____ ft., From _____ ft. to _____ ft.			

6 GROUT MATERIAL:	1 Neat cement	2 Cement grout	3 Bentonite	<input checked="" type="checkbox"/> 4 Other Hole plug _____
Grout Intervals: From <u>20</u> ft. to <u>0</u> ft., From _____ ft. to _____ ft., From _____ ft. to _____ ft.				
What is the nearest source of possible contamination:				
1 Septic tank	4 Lateral lines	7 Pit privy	10 Livestock pens	14 Abandoned water well
2 Sewer lines	5 Cess pool	8 Sewage lagoon	11 Fuel storage	15 Oil well/Gas well
3 Watertight sewer lines	6 Seepage pit	9 Feedyard	12 Fertilizer storage	16 Other (specify below)
13 Insecticide storage				
Direction from well?	How many feet?			

FROM	TO	LITHOLOGIC LOG	FROM	TO	PLUGGING INTERVALS
0	3	Top soil			
3	7	Brown clay			
7	18	Sand and gravel			
18	18 1/2	Brown clay			
18 1/2	34	Sand and gravel			
34	40	Brown clay			

7 CONTRACTOR'S OR LANDOWNER'S CERTIFICATION: This water well was (1) constructed, (2) reconstructed, or (3) plugged under my jurisdiction and was completed on (mo/day/year) 7-30-94 and this record is true to the best of my knowledge and belief. Kansas Water Well Contractor's License No. 134. This Water Well Record was completed on (mo/day/yr) \_\_\_\_\_ under the business name of Rosencrantz-Bemis Ent., Inc. by (signature) Greg Datta

INSTRUCTIONS: Use typewriter or ball point pen. PLEASE PRESS FIRMLY and PRINT clearly. Please fill in blanks, underline or circle the correct answers. Send top three copies to Kansas Department of Health and Environment, Bureau of Water, Topeka, Kansas 66620-0001. Telephone: 913-296-5545. Send one to WATER WELL OWNER and retain one for your records.