


1 LOCATION OF WATER WELL: County: <u>Rice</u>	Fraction <u>NE</u> $\frac{1}{4}$ <u>SW</u> $\frac{1}{4}$ <u>NW</u> $\frac{1}{4}$	Section Number <u>14</u>	Township Number <u>T 21 S</u>	Range Number <u>R 9 E/W</u>
--	---	-----------------------------	----------------------------------	--------------------------------

Distance and direction from nearest town or city street address of well if located within city?  
Approximately 1 1/4 miles east and 1 1/4 miles south of Alden

2 WATER WELL OWNER: RR#, St. Address, Box # : City, State, ZIP Code :	<u>Jomax Construction Co., Inc.</u> <u>South Hwy 281</u> <u>Great Bend, KS 67530</u>	Temporary Permit Board of Agriculture, Division of Water Resources Application Number: <u>980276</u>
---	--	--

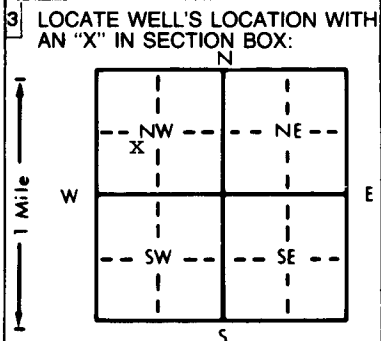

4 DEPTH OF COMPLETED WELL: <u>30</u> ft. ELEVATION: <u>unknown</u>
Depth(s) Groundwater Encountered 1. .... ft. 2. .... ft. 3. .... ft.
WELL'S STATIC WATER LEVEL <u>3</u> ft. below land surface measured on <u>mo/day/yr</u> <u>11-13-98</u>
Pump test data: Well water was <u>not ch'd.</u> ft. after .... hours pumping .... gpm
Est. Yield <u>unknown</u> gpm: Well water was .... ft. after .... hours pumping .... gpm
Bore Hole Diameter <u>24</u> in. to <u>30</u> ft., and .... in. to .... ft.
WELL WATER TO BE USED AS:
5 Public water supply      8 Air conditioning      11 Injection well
1 Domestic      3 Feedlot      6 Oil field water supply      9 <u>Dewatering</u> 12 Other (Specify below)
2 Irrigation      4 Industrial      7 Lawn and garden only      10 Monitoring well
Was a chemical/bacteriological sample submitted to Department? Yes.....No..... <u>X</u> ; If yes, mo/day/yr sample was submitted
Water Well Disinfected? Yes      No <u>X</u>

5 TYPE OF BLANK CASING USED:	5 Wrought iron	8 Concrete tile	CASING JOINTS: Glued      Clamped
1 <u>Steel</u>	3 RMP (SR)	6 Asbestos-Cement	9 Other (specify below)
2 PVC	4 ABS	7 Fiberglass	Welded <u>X</u>
Blank casing diameter <u>16</u> in. to <u>6</u> ft., Dia. .... in. to .... ft., Dia. .... in. to .... ft.			Threaded.....
Casing height above land surface <u>0</u> in., weight <u>36.87</u> lbs./ft. Wall thickness or gauge No. <u>219</u>			
TYPE OF SCREEN OR PERFORATION MATERIAL:		7 PVC	10 Asbestos-cement
1 <u>Steel</u>	3 Stainless steel	5 Fiberglass	8 RMP (SR)
2 Brass	4 Galvanized steel	6 Concrete tile	9 ABS
SCREEN OR PERFORATION OPENINGS ARE:		5 Gauzed wrapped	8 Saw cut
1 Continuous slot	3 Mill slot	6 Wire wrapped	9 Drilled holes
2 Louvered shutter	4 Key punched	7 Torch cut	10 Other (specify) <u>Bridge Slot</u>
SCREEN-PERFORATED INTERVALS: From <u>6</u> ft. to <u>30</u> ft., From .... ft. to .... ft.			
GRAVEL PACK INTERVALS: From <u>0</u> ft. to <u>30</u> ft., From .... ft. to .... ft.			

6 GROUT MATERIAL:	1 Neat cement	2 Cement grout	3 Bentonite	4 Other
Grout Intervals: From <u>0</u> ft. to <u>3</u> ft., From .... ft. to .... ft., From .... ft. to .... ft.				
What is the nearest source of possible contamination:			10 Livestock pens	14 Abandoned water well
1 Septic tank	4 Lateral lines	7 Pit privy	11 Fuel storage	15 Oil well/Gas well
2 Sewer lines	5 Cess pool	8 Sewage lagoon	12 Fertilizer storage	16 Other (specify below)
3 Watertight sewer lines	6 Seepage pit	9 Feedyard	13 Insecticide storage	None known.....

Direction from well?		LITHOLOGIC LOG		PLUGGING INTERVALS	
FROM	TO	FROM	TO	FROM	TO
0	1				
		Topsoil			
1	5	Sand, fine			
5	15	Sand and gravel, medium, coarse			
15	27	Sand and gravel, medium, very coarse			
27	28	Clay, brown, sandy			
28	30	Clay, grayish brown			

7 CONTRACTOR'S OR LANDOWNER'S CERTIFICATION: This water well was (1) <u>constructed</u> , (2) reconstructed, or (3) plugged under my jurisdiction and was completed on (mo/day/year) <u>11-13-98</u> and this record is true to the best of my knowledge and belief. Kansas Water Well Contractor's License No. <u>185</u> This Water Well Record was completed on (mo/day/yr) <u>11-28-98</u> under the business name of <u>Clarke Well &amp; Equipment, Inc.</u> by (signature) <u>[Signature]</u>
--

OFFICE USE ONLY  
T  
R  
EW  
SEC