


1 LOCATION OF WATER WELL: County: Rice	Fraction NE 1/4 SW 1/4 NW 1/4	Section Number 14	Township Number T 21 S	Range Number R 9 EW
---	----------------------------------	----------------------	---------------------------	------------------------

Distance and direction from nearest town or city street address of well if located within city?

Approximately 1 1/4 miles east and 1 1/4 miles south of Alden

2 WATER WELL OWNER: RR#, St. Address, Box # : City, State, ZIP Code :	Jomax Construction Co., Inc. South Hwy 281 Great Bend, KS 67530	Temporary Permit Board of Agriculture, Division of Water Resources Application Number: 980277
---	---	---

3 LOCATE WELL'S LOCATION WITH AN "X" IN SECTION BOX:

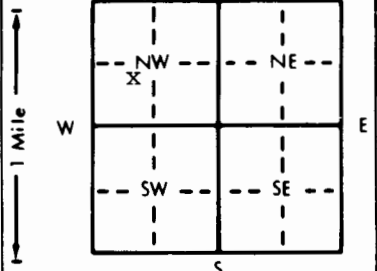

4 DEPTH OF COMPLETED WELL: 30 ft. ELEVATION: unknown
Depth(s) Groundwater Encountered 1. ft. 2. ft. 3. ft.
WELL'S STATIC WATER LEVEL 3 ft. below land surface measured on mo/day/yr 11-13-98
Pump test data: Well water was not ch'd ft. after hours pumping gpm
Est. Yield unknown gpm: Well water was ft. after hours pumping gpm
Bore Hole Diameter 24 in. to 30 ft., and in. to ft.
WELL WATER TO BE USED AS: 5 Public water supply 8 Air conditioning 11 Injection well 1 Domestic 3 Feedlot 6 Oil field water supply 9 Dewatering 12 Other (Specify below) 2 Irrigation 4 Industrial 7 Lawn and garden only 10 Monitoring well
Was a chemical/bacteriological sample submitted to Department? Yes No <input checked="" type="checkbox"/>; If yes, mo/day/yr sample was sub- mitted
Water Well Disinfected? Yes No <input checked="" type="checkbox"/>

5 TYPE OF BLANK CASING USED:	5 Wrought iron	8 Concrete tile	CASING JOINTS: Glued Clamped
1 Steel	3 RMP (SR)	6 Asbestos-Cement	9 Other (specify below)
2 PVC	4 ABS	7 Fiberglass	Welded X
Blank casing diameter 16 in. to 6 ft., Dia in. to ft., Dia in. to ft.			Threaded
Casing height above land surface 0 in., weight 36.87 lbs./ft. Wall thickness or gauge No. 219			
TYPE OF SCREEN OR PERFORATION MATERIAL:	7 PVC	10 Asbestos-cement	
1 Steel	3 Stainless steel	5 Fiberglass	8 RMP (SR)
2 Brass	4 Galvanized steel	6 Concrete tile	9 ABS
SCREEN OR PERFORATION OPENINGS ARE:	5 Gauzed wrapped	8 Saw cut	11 None (open hole)
1 Continuous slot	3 Mill slot	6 Wire wrapped	9 Drilled holes
2 Louvered shutter	4 Key punched	7 Torch cut	10 Other (specify) Bridge Slot
SCREEN-PERFORATED INTERVALS: From 6 ft. to 30 ft., From ft. to ft.			
GRAVEL PACK INTERVALS: From 0 ft. to 30 ft., From ft. to ft.			

6 GROUT MATERIAL:	1 Neat cement	2 Cement grout	3 Bentonite	4 Other
Grout Intervals: From 0 ft. to 3 ft., From ft. to ft., From ft. to ft.				
What is the nearest source of possible contamination:	1 Septic tank	4 Lateral lines	7 Pit privy	10 Livestock pens
2 Sewer lines	5 Cess pool	8 Sewage lagoon	12 Fertilizer storage	14 Abandoned water well
3 Watertight sewer lines	6 Seepage pit	9 Feedyard	13 Insecticide storage	15 Oil well/Gas well
				16 Other (specify below)
				None known

Direction from well?		LITHOLOGIC LOG		PLUGGING INTERVALS	
FROM	TO	FROM	TO	FROM	TO
0	1				
1	4		Topsoil		
4	27		Sand, fine		
27	30		Sand and gravel, medium, coarse		
			Clay, brown with sand		

7 CONTRACTOR'S OR LANDOWNER'S CERTIFICATION: This water well was (1) constructed, (2) reconstructed, or (3) plugged under my jurisdiction and was completed on (mo/day/year) 11-13-98 and this record is true to the best of my knowledge and belief. Kansas Water Well Contractor's License No. 185 This Water Well Record was completed on (mo/day/yr) 11-28-98 under the business name of Clarke Well & Equipment, Inc. by (signature)
