


|                           |  |                |                |                 |              |
|---------------------------|--|----------------|----------------|-----------------|--------------|
| 1 LOCATION OF WATER WELL: |  | Fraction       | Section Number | Township Number | Range Number |
| County: Rice              |  | SW ¼ NW ¼ NW ¼ | 14             | T 21 S          | R 9 E/W      |

Distance and direction from nearest town or city street address of well if located within city?  
 Approximately 1 1/4 miles east and 1 1/4 miles south of Alden

|                           |                              |   |
|---------------------------|------------------------------|---|
| 2 WATER WELL OWNER:       | Jomax Construction Co., Inc. | Temporary Permit                                  |
| RR#, St. Address, Box # : | South Hwy 281                | Board of Agriculture, Division of Water Resources |
| City, State, ZIP Code :   | Great Bend, KS 67530         | Application Number: 980274                        |

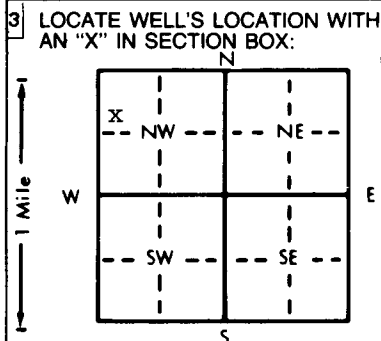

|  |                    |                          |                    |                          |
|--|--------------------|--------------------------|--------------------|--------------------------|
| 4 DEPTH OF COMPLETED WELL: 30 ft.  | ELEVATION:         |                          |                    |                          |
| Depth(s) Groundwater Encountered 1. .... ft. 2. .... ft. 3. .... ft.   |                    |                          |                    |                          |
| WELL'S STATIC WATER LEVEL: 3 ft. below land surface measured on mo/day/yr 11/19/98                                     |                    |                          |                    |                          |
| Pump test data: Well water was .... ft. after .... hours pumping .... gpm  |                    |                          |                    |                          |
| Est. Yield .... gpm: Well water was .... ft. after .... hours pumping .... gpm   |                    |                          |                    |                          |
| Bore Hole Diameter: .... in. to .... ft., and .... in. to .... ft.   |                    |                          |                    |                          |
| WELL WATER TO BE USED AS:  |                    |                          |                    |                          |
| 1 Domestic   | 3 Feedlot          | 6 Oil field water supply | 9 Dewatering       | 12 Other (Specify below) |
| 2 Irrigation   | 4 Industrial       | 7 Lawn and garden only   | 10 Monitoring well |                          |
| 5 Public water supply  | 8 Air conditioning | 11 Injection well        |                    |                          |
| Was a chemical/bacteriological sample submitted to Department? Yes.....No.....; If yes, mo/day/yr sample was submitted |                    |                          |                    |                          |
| Water Well Disinfected? Yes No   |                    |                          |                    |                          |

|   |                         |                                      |                         |                          |
|---|-------------------------|--------------------------------------|-------------------------|--------------------------|
| 5 TYPE OF BLANK CASING USED:                                | 5 Wrought iron          | 8 Concrete tile                      | CASING JOINTS: Glued    | Clamped                  |
| 1 Steel   | 3 RMP (SR)              | 6 Asbestos-Cement                    | 9 Other (specify below) | Welded                   |
| 2 PVC   | 4 ABS                   | 7 Fiberglass                         |                         | Threaded                 |
| Blank casing diameter: 16 in. to                            | ft. Dia                 | in. to                               | ft., Dia                | in. to                   |
| Casing height above land surface: All casing was pulled out | in. weight              | lbs./ft. Wall thickness or gauge No. |                         |                          |
| TYPE OF SCREEN OR PERFORATION MATERIAL:                     | 7 PVC                   | 10 Asbestos-cement                   |                         |                          |
| 1 Steel   | 3 Stainless steel       | 5 Fiberglass                         | 8 RMP (SR)              | 11 Other (specify) NA    |
| 2 Brass   | 4 Galvanized steel      | 6 Concrete tile                      | 9 ABS                   | 12 None used (open hole) |
| SCREEN OR PERFORATION OPENINGS ARE:                         | 5 Gauzed wrapped        | 8 Saw cut                            | 11 None (open hole)     |                          |
| 1 Continuous slot   | 3 Mill slot             | 6 Wire wrapped                       | 9 Drilled holes         |                          |
| 2 Louvered shutter  | 4 Key punched           | 7 Torch cut                          | 10 Other (specify) NA   |                          |
| SCREEN-PERFORATED INTERVALS:                                | From 999 ft. to 999 ft. | From                                 | ft. to                  | ft.                      |
| GRAVEL PACK INTERVALS:                                      | From                    | ft. to                               | ft., From               | ft. to                   |

|   |                 |                 |                        |                          |
|---|-----------------|-----------------|------------------------|--------------------------|
| 6 GROUT MATERIAL:                                     | 1 Neat cement   | 2 Cement grout  | 3 Bentonite            | 4 Other Sand and clay    |
| Grout Intervals:                                      | From            | ft. to          | ft., From              | ft. to 30 ft. to 0 ft.   |
| What is the nearest source of possible contamination: |                 |                 |                        |                          |
| 1 Septic tank   | 4 Lateral lines | 7 Pit privy     | 10 Livestock pens      | 14 Abandoned water well  |
| 2 Sewer lines   | 5 Cess pool     | 8 Sewage lagoon | 11 Fuel storage        | 15 Oil well/Gas well     |
| 3 Watertight sewer lines                              | 6 Seepage pit   | 9 Feedyard      | 12 Fertilizer storage  | 16 Other (specify below) |
|   |                 |                 | 13 Insecticide storage | None known               |
| Direction from well?                                  | How many feet?  |                 |                        |                          |

| FROM  | TO | FROM | TO | PLUGGING INTERVALS   |
|---|----|------|----|--|
| <b>PLUGGING NOTE:</b> This well was used to lower the water level from 3 feet to approximately 12 feet below surface. After a new 24" pipeline was installed under an existing large pipeline, the pump was removed. The well abandonment as follows: |    |      |    |  |
|   |    |      |    | 1. Well was chlorinated.   |
|   |    |      |    | 2. The entire 16" x 30' long casing was pulled out. Because of the high water table and very loose gravel, the original 24" borehole collapsed immediately to approximately 4 feet below ground. |
|   |    |      |    | 3. The large bell hole was filled with topsoil from 4 feet to surface.   |
|   |    |      |    | Summary: The geological condition after the casing was removed remains the same as pre-existing condition.   |

|  |   |
|--|---|
| 7 CONTRACTOR'S OR LANDOWNER'S CERTIFICATION: | This water well was (1) constructed, (2) reconstructed, or (3) plugged under my jurisdiction and was completed on (mo/day/year) 11/19/98 and this record is true to the best of my knowledge and belief. Kansas Water Well Contractor's License No. 185 This Water Well Record was completed on (mo/day/yr) 11/28/98 under the business name of Clarke Well & Equipment, Inc. by (signature) <i>Clarke Well &amp; Equipment</i> |
|--|---|

OFFICE USE ONLY  
T  
R  
EW  
SEC.