


1 LOCATION OF WATER WELL: Fraction **NE ¼ SE ¼ SE ¼** Section Number **15** Township Number **T 21 S** Range Number **R 09 W**
 County: **Rice**

Distance and direction from nearest town or city street address of well if located within city?
2135 11th Road - Alden, Kansas

2 WATER WELL OWNER: **ANR Pipe Line**
 RR#, St. Address, Box # : **2135 11th Road** Board of Agriculture, Division of Water Resources
 City, State, ZIP Code : **Alden, Kansas 67512-9314** Application Number: _____

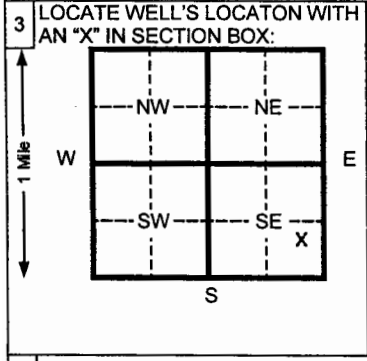

4 DEPTH OF COMPLETED WELL **10.0** ft. ELEVATION: _____
 Depth(s) Groundwater Encountered 1 _____ ft. 2 _____ ft. 3 _____ ft.
 WELL'S STATIC WATER LEVEL _____ ft. below land surface measured on mo/day/yr
 Pump test data: Well water was _____ ft. after _____ hours pumping _____ gpm
 Est. Yield _____ gpm: Well water was _____ ft. after _____ hours pumping _____ gpm
 Bore Hole Diameter **8.5** in. to **10.5** ft. and _____ in. to _____ ft.
 WELL WATER TO BE USED AS: 5 Public water supply 8 Air conditioning 11 Injection well
 1 Domestic 3 Feed lot 6 Oil field water supply 9 Dewatering 12 Other (Specify below)
 2 Irrigation 4 Industrial 7 Lawn and garden (domestic) **10 Monitoring well**
 Was a chemical/bacteriological sample submitted to Department? Yes _____ No **X** If yes, mo/day/yr sample was submitted _____
 Water Well Disinfected? Yes _____ No **X**

5 TYPE OF BLANK CASING USED: 5 Wrought Iron 8 Concrete tile CASING JOINTS: Glued _____ Clamped _____
 1 Steel 3 RMP (SR) 6 Asbestos-Cement 9 Other (specify below) Welded _____
2 PVC 4 ABS 7 Fiberglass **Flush**
 Blank casing diameter **2** in. to **5.0** ft., Dia _____ in. to _____ ft., Dia _____ in. to _____ ft.
 Casing height above land surface **30** in., weight **0.703** lbs./ft. Wall thickness or gauge No. **SCH. 40**
 TYPE OF SCREEN OR PERFORATION MATERIAL: **7 PVC** 10 Asbestos-cement
 1 Steel 3 Stainless steel 5 Fiberglass 8 RMP (SR) 11 Other (specify)
 2 Brass 4 Galvanized steel 6 Concrete tile 9 ABS 12 None used (open hole)
 SCREEN OR PERFORATION OPENINGS ARE: 5 Gauzed wrapped 8 Saw cut 11 None (open hole)
 1 Continuous slot **3 Mill slot** 6 Wire wrapped 9 Drilled holes
 2 Louvered shutter 4 Key punched 7 Torch cut 10 Other (specify) _____
 SCREEN-PERFORATED INTERVALS: From **5.0** ft. to **10.0** ft. From _____ ft. to _____ ft.
 GRAVEL PACK INTERVALS: From **3.0** ft. to **10.5** ft. From _____ ft. to _____ ft.

6 GROUT MATERIAL: 1 Neat cement 2 Cement grout **3 Bentonite** 4 Other _____
 Grout Intervals From **1.0** ft. to **3.0** ft. From _____ ft. to _____ ft. From _____ ft. to _____ ft.
 What is the nearest source of possible contamination:
 1 Septic tank 4 Lateral lines 7 Pit privy 10 Livestock pens 14 Abandoned water well
 2 Sewer lines 5 Cess pool 8 Sewage lagoon 11 Fuel storage 15 Oil well/ Gas well
 3 Watertight sewer lines 6 Seepage pit 9 Feedyard 12 Fertilizer storage 16 Other (specify below)
 13 Insecticide storage

Direction from well? _____ How many feet? _____

| FROM | TO | CODE | LITHOLOGIC LOG | FROM | TO | PLUGGING INTERVALS |
|------|------|------|--------------------------------|------|----|--------------------|
| 0 | 0.8 | | Topsoil | | | |
| 0.8 | 7 | | Sand, loose, f-m, brown | | | |
| 7 | 10.5 | | Sand, f-c, brown, trace gravel | | | |
| | | | | | | |
| | | | | | | |
| | | | | | | |
| | | | | | | |
| | | | | | | |
| | | | | | | |
| | | | | | | |

7 CONTRACTOR'S OR LANDOWNER'S CERTIFICATION: This water well was **(1) constructed**, (2) reconstructed, or (3) plugged under my jurisdiction and was completed on (mo/day/yr) **6/14/06** and this record is true to the best of my knowledge and belief. Kansas Water Well Contractor's License No. **531** This Water Well Record was completed on (mo/day/yr) **7/10/06** under the business name of **Geotechnical Services Inc.** by (signature) _____