


Location of well: **1/4 NE 3** SECT **3** TOWN **21** RANGE **9 W**

2. Distance and direction from nearest town or city: _____
 Street address of well or of community: _____
 City, state, zip code: _____

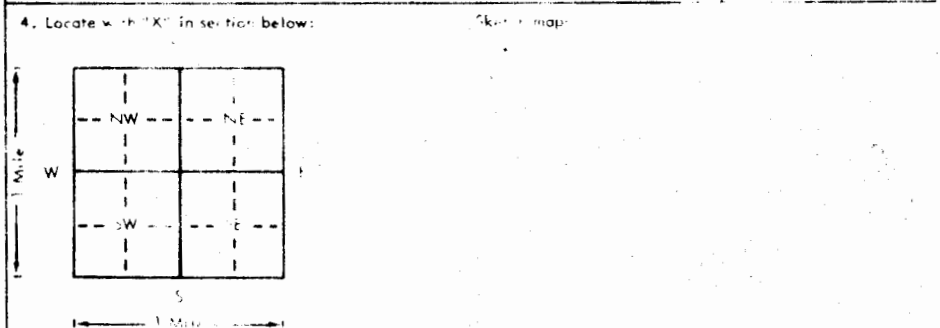

5. Type and amount of material

	From	To
Top soil	0	5
Clean gravel	5	25
Clay	25	28
Gravel	28	42

6. Date of installation: **3/16**
 Resident: **42** Date: **6/15/77**
 7. Rotary Driven Dig
 Hollow rod Jetter Bored Reverse rotary
 8. Use: Domestic Public supply Irrigation
 IRR Air conditioning Stock
 Lawn (Or field water) Other _____
 9. Casing Material: **3/8" dia. A36** or below
 Threaded Welded Surface in
 RMP: _____ PWT: _____ Weight: _____
 Dia: _____ Depth: _____ Wall thickness: _____
 Dia: _____ Depth: _____ Dia: **3/16**

10. Screens: Manufacturer's name: **Johnson**
 Type: **sawed** Dia: _____
 Slot size: **3/16**
 Set between _____ ft. and _____ ft.
 _____ ft. and _____ ft.
 Gravel tank? **yes** Size range of material: **1/8-1/4**
 11. Static water level: _____ mo. day yr.
6 ft. below land surface Date **6/15/77**
 12. Pumping level below land surfaces:
 _____ ft. after _____ hrs. pumping _____ g.p.m.
 _____ ft. after _____ hrs. pumping _____ g.p.m.
 Estimated maximum yield: _____ g.p.m.
 13. Water sample submitted: _____ mo. day yr.
 Yes No Date _____

14. Well head completion:
 Pitless adapter _____ inches above grade
 15. Well grouted? **yes**
 With: Neat cement Bentonite Concrete
 Depth From _____ ft. to _____ ft.
 16. Nearest source of possible contamination
 ft. _____ Direction _____ Type _____
 Well disinfected upon completion? yes No
 17. Pump: _____ Not installed
 Manufacturer's name: **Berkley**
 Model number _____ HP _____ Volts _____
 Length of drop pipe _____ ft. capacity _____ g.p.m.
 Type:
 Submersible Turbine
 Jet Reciprocating
 Centrifugal Other _____

18. Elevation:
 Topography:
 Hill
 Slope
 Upland
 Valley

19. Remarks:
 (Use a second sheet if needed)

20. Water well contractor's certification:
 This well was drilled under my jurisdiction and this report is true to the best of my knowledge and belief.
Darling Drilling Co. 189
 Business name _____ License No. _____
 Address **1211 W. 4th, Hutchinson, Ks.**
 Signed _____ Date _____
 Authorized representative