


AS-4

1 LOCATION OF WATER WELL: Fraction NE 1/4 NW 1/4 NE 1/4 Section Number 9 Township Number T 21 S Range Number R 9 E

Distance and direction from nearest town or city street address of well if located within city?
 213 N. Pioneer, Alden, KS.

2 WATER WELL OWNER: Tom & Minnie Myers
 RR#, St. Address, Box #: 213 N. Pioneer
 City, State, ZIP Code: Alden, KS.
 Board of Agriculture, Division of Water Resources
 Application Number:

3 LOCATE WELL'S LOCATION WITH AN "X" IN SECTION BOX:

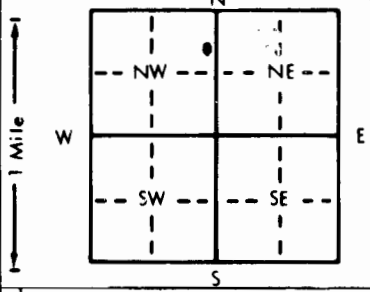

4 DEPTH OF COMPLETED WELL: 27.0' ft. ELEVATION: ft.
 Depth(s) Groundwater Encountered 1. 18.0' ft. 2. ft. 3. ft.
 WELL'S STATIC WATER LEVEL 10.23 ft. below land surface measured on mo/day/yr 4-23-98
 Pump test data: Well water was ft. after hours pumping gpm
 Est. Yield gpm Well water was ft. after hours pumping gpm
 Bore Hole Diameter: 8 1/2" in. to 27' ft., and in. to ft.
 WELL WATER TO BE USED AS: 5 Public water supply 8 Air conditioning 11 Injection well
 1 Domestic 3 Feedlot 6 Oil field water supply 9 Dewatering 12 Other (Specify below) AIR SPARGE
 2 Irrigation 4 Industrial 7 Lawn and garden only 10 Monitoring well
 Was a chemical/bacteriological sample submitted to Department? Yes No X If yes, mo/day/yr sample was submitted
 Water Well Disinfected? Yes No X

5 TYPE OF BLANK CASING USED: 5 Wrought iron 8 Concrete tile CASING JOINTS: Glued Clamped
 1 Steel 3 RMP (SR) 6 Asbestos-Cement 9 Other (specify below) Welded
2 PVC 4 ABS 7 Fiberglass Threaded X

Blank casing diameter 2.375 in. to 25' ft., Dia in. to ft., Dia in. to SDR 13 ft.
 Casing height above land surface FLUSH MT. in., weight lbs./ft. Wall thickness or gauge No. SCH 40

TYPE OF SCREEN OR PERFORATION MATERIAL: 7 PVC 10 Asbestos-cement
 1 Steel 3 Stainless steel 5 Fiberglass 8 RMP (SR) 11 Other (specify)
 2 Brass 4 Galvanized steel 6 Concrete tile 9 ABS 12 None used (open hole)

SCREEN OR PERFORATION OPENINGS ARE: 5 Gauzed wrapped 8 Saw cut 11 None (open hole)
 1 Continuous slot 3 Mill slot 6 Wire wrapped 9 Drilled holes
 2 Louvered shutter 4 Key punched 7 Torch cut 10 Other (specify)

SCREEN-PERFORATED INTERVALS: From 27.0' ft. to 25.0' ft., From ft. to ft.
 From ft. to ft., From ft. to ft.
 GRAVEL PACK INTERVALS: From 27.0' ft. to 18.0' ft., From ft. to ft.
 From ft. to ft., From ft. to ft.

6 GROUT MATERIAL: 1 Neat cement 2 Cement grout 3 Bentonite 4 Other
 Grout Intervals: From 18.0' ft. to 10.0' ft., From 10.0' ft. to 0.0' ft., From ft. to ft.

What is the nearest source of possible contamination: 2 10 Livestock pens 14 Abandoned water well
 1 Septic tank 4 Lateral lines 7 Pit privy 11 Fuel storage 15 Oil well/Gas well
 2 Sewer lines 5 Cess pool 8 Sewage lagoon 12 Fertilizer storage 16 Other (specify below)
 3 Watertight sewer lines 6 Seepage pit 9 Feedyard 13 Insecticide storage
 Direction from well? NW How many feet? 20'

FROM	TO	LITHOLOGIC LOG	FROM	TO	PLUGGING INTERVALS
0	1	Gravel			
1	5	Brn clay, moist, soft, slight odor.			
5	10	Sand, moist, fine, slight odor, well sorted.			
10	20	Sand, fine grained, well sorted, turning green, mod.-high odor.			
20	27	Gravel, wet, med-coarse, poorly sorted, med-large cobbles, strong odor.			

*Washed sand in before
 Flush Mt. OK'd by Don Taylor*

7 CONTRACTOR'S OR LANDOWNER'S CERTIFICATION: This water well was (constructed, (2) reconstructed, or (3) plugged under my jurisdiction and was completed on (mo/day/year) 4-23-98 and this record is true to the best of my knowledge and belief. Kansas Water Well Contractor's License No. 539 This Water Well Record was completed on (mo/day/yr) 6-22-98 under the business name of JB Environmental Drilling by (signature) James Becken

OFFICE USE ONLY
 T
 R
 EW
 SEC.
 1/4
 1/4
 1/4