


1 LOCATION OF WATER WELL: County: Rice	Fraction NW 1/4 NE 1/4 NE 1/4	Section Number 18	Township Number T 21 S	Range Number R 9 <del>XX</del> EW
---	----------------------------------	----------------------	---------------------------	--------------------------------------

Distance and direction from nearest town or city street address of well if located within city?  
 Approx. 1 mile south and 2 miles west of Alden, KS

2 WATER WELL OWNER: Lon Elliott (This is Well #5 of a 5 well manifold system: wells spaced 50' apart:  
 RR#, St. Address, Box #: Route 2 800 GPM Total) Board of Agriculture, Division of Water Resources  
 City, State, ZIP Code: Sterling, KS 67570 Application Number: not available

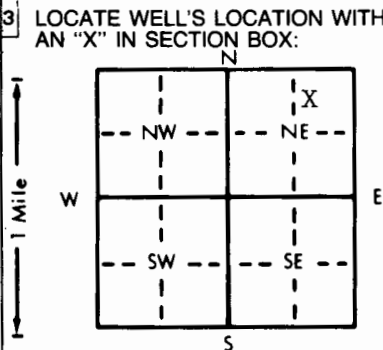

4 DEPTH OF COMPLETED WELL: 32 ft. ELEVATION: unknown  
 Depth(s) Groundwater Encountered 1. 9 ft. 2. ft. 3. ft.  
 WELL'S STATIC WATER LEVEL: 9 ft. below land surface measured on mo/day/yr 5-11-82  
 Pump test data: Well water was unknown ft. after hours pumping gpm  
 Est. Yield above gpm: Well water was ft. after hours pumping gpm  
 Bore Hole Diameter: 24 in. to 32 ft., and in. to ft.  
 WELL WATER TO BE USED AS:  
 5 Public water supply 8 Air conditioning 11 Injection well  
 1 Domestic 3 Feedlot 6 Oil field water supply 9 Dewatering 12 Other (Specify below)  
 2 Irrigation 4 Industrial 7 Lawn and garden only 10 Observation well  
 Was a chemical/bacteriological sample submitted to Department? Yes No X; If yes, mo/day/yr sample was submitted Water Well Disinfected? Yes No X

5 TYPE OF BLANK CASING USED:  
 1 Steel 3 RMP (SR) 5 Wrought iron 8 Concrete tile CASING JOINTS: Glued Clamped  
 2 PVC 4 ABS 6 Asbestos-Cement 9 Other (specify below) Welded XX  
 7 Fiberglass Threaded  
 Blank casing diameter 16 in. to 12 ft., Dia. in. to ft., Dia. in. to ft.  
 Casing height above land surface 12 in., weight 42.05 lbs./ft. Wall thickness or gauge No. 250  
 TYPE OF SCREEN OR PERFORATION MATERIAL:  
 1 Steel 3 Stainless steel 5 Fiberglass 7 PVC 10 Asbestos-cement  
 2 Brass 4 Galvanized steel 6 Concrete tile 8 RMP (SR) 11 Other (specify)  
 12 None used (open hole)  
 SCREEN OR PERFORATION OPENINGS ARE:  
 1 Continuous slot 3 Mill slot 5 Gauzed wrapped 8 Saw cut 11 None (open hole)  
 2 Louvered shutter 4 Key punched 6 Wire wrapped 9 Drilled holes  
 7 Torch cut 10 Other (specify) Doerr Bridge Slot  
 SCREEN-PERFORATED INTERVALS: From 12 ft. to 32 ft., From ft. to ft.  
 GRAVEL PACK INTERVALS: From 10 ft. to 32 ft., From ft. to ft.

6 GROUT MATERIAL: 1 Neat cement 2 Cement grout 3 Bentonite 4 Other  
 Grout Intervals: From 0 ft. to 10 ft., From ft. to ft., From ft. to ft.  
 What is the nearest source of possible contamination:  
 1 Septic tank 4 Lateral lines 7 Pit privy 10 Livestock pens 14 Abandoned water well  
 2 Sewer lines 5 Cess pool 8 Sewage lagoon 11 Fuel storage 15 Oil well/Gas well  
 3 Watertight sewer lines 6 Seepage pit 9 Feedyard 12 Fertilizer storage 16 Other (specify below) FIELD  
 13 Insecticide storage  
 Direction from well? ALL How many feet?

FROM	TO	LITHOLOGIC LOG	FROM	TO	LITHOLOGIC LOG
0	5	Sandy topsoil & sandy clay			
5	32	Sand & gravel, med., some coarse			

7 CONTRACTOR'S OR LANDOWNER'S CERTIFICATION: This water well was (1) constructed, (2) reconstructed, or (3) plugged under my jurisdiction and was completed on (mo/day/year) 5/11/82 and this record is true to the best of my knowledge and belief. Kansas Water Well Contractor's License No. 185 This Water Well Record was completed on (mo/day/yr) 5/21/82 under the business name of CLARKE WELL & EQ., INC. by (signature) [Signature]

INSTRUCTIONS: Use typewriter or ball point pen, PLEASE PRESS FIRMLY and PRINT clearly. Please fill in blanks, underline or circle the correct answers. Send top three copies to Kansas Department of Health and Environment, Division of Environment, Environmental Geology Section, Topeka, KS 66620. Send one to WATER WELL OWNER and retain one for your records.