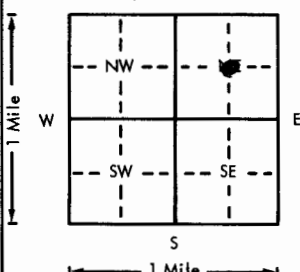


USE TYPEWRITER OR BALL POINT PEN-PRESS FIRMLY, PRINT CLEARLY.

WATER WELL RECORD
KSA 82a-1201-1215

Kansas Department of Health and Environment-Division of Environment (Water well Contractors) Topeka, Kansas 66620

1. Location of well:	County Rice	Fraction NE 1/4 C 1/4 1/4 1/4	Section number 3	Township number T 21	Range number S R 9W E/W
2. Distance and direction from nearest town or city: Street address of well location if in city: 1 N 3/4 E ALDEN			3. Owner of well: Fred Shuyler R.R. or street: R.F.D. City, state, zip code: Alden, Kansas 67512		
4. Locate with "X" in section below: Sketch map: 			6. Bore hole dia. 28 in. Completion date 4-7-77 Well depth 60 ft.		
5. Type and color of material			7. <input type="checkbox"/> Cable tool <input type="checkbox"/> Rotary <input type="checkbox"/> Driven <input type="checkbox"/> Dug <input type="checkbox"/> Hollow rod <input type="checkbox"/> Jetted <input checked="" type="checkbox"/> Bored <input checked="" type="checkbox"/> Reverse rotary		
			8. Use: <input type="checkbox"/> Domestic <input type="checkbox"/> Public supply <input type="checkbox"/> Industry <input checked="" type="checkbox"/> Irrigation <input type="checkbox"/> Air conditioning <input type="checkbox"/> Stock <input type="checkbox"/> Lawn <input type="checkbox"/> Oil field water <input type="checkbox"/> Other		
From To			9. Casing: Material Transite Height: Above or below Threaded <input type="checkbox"/> Welded <input type="checkbox"/> Surface 12 in. RMP <input type="checkbox"/> PVC <input type="checkbox"/> Weight 30 lbs./ft. Dia. 16 in. to 37 ft. depth Wall Thickness: inches or Dia. <input type="checkbox"/> in. to <input type="checkbox"/> ft. depth gage No. 226 1/8		
			10. Screen: Manufacturer's name Johnson Type sawed Dia. 16 Slot/gauze 3/16 Length 26 Set between <input type="checkbox"/> ft. and <input type="checkbox"/> ft. 34 ft. and 60 ft. Gravel pack? yes Size range of material 1/8-1/4		
Soil			11. Static water level: <input type="checkbox"/> mo./day/yr. 14 ft. below land surface Date 3-8-77		
Fine sand			12. Pumping level below land surfaces: 36 ft. after 6 hrs. pumping 600 g.p.m. 38 ft. after 7 hrs. pumping 700 g.p.m. Estimated maximum yield 800 g.p.m.		
Med. to coarse gravel			13. Water sample submitted: <input type="checkbox"/> mo./day/yr. <input type="checkbox"/> Yes <input type="checkbox"/> No Date		
Fine sand			14. Well head completion: <input type="checkbox"/> Pitless adapter <input type="checkbox"/> inches above grade		
Med. sand			15. Well grouted? yes With: <input type="checkbox"/> Neat cement <input checked="" type="checkbox"/> Bentonite <input type="checkbox"/> Concrete Depth: From 0 ft. to 10 ft.		
Coarse sand and gravel			16. Nearest source of possible contamination: ft. <input type="checkbox"/> Direction <input type="checkbox"/> Type <input type="checkbox"/> Well disinfected upon completion? <input type="checkbox"/> Yes no No		
(Use a second sheet if needed)			17. Pump: <input type="checkbox"/> Not installed Manufacturer's name Western Land Roller Model number 3312CAN HP 60 Volts 440 Length of drop pipe 50 ft. capacity <input type="checkbox"/> g.p.m. Type: <input type="checkbox"/> Submersible <input checked="" type="checkbox"/> Turbine <input type="checkbox"/> Jet <input type="checkbox"/> Reciprocating <input type="checkbox"/> Centrifugal <input type="checkbox"/> Other		
18. Elevation: Topography: <input type="checkbox"/> Hill <input type="checkbox"/> Slope <input checked="" type="checkbox"/> Upland <input type="checkbox"/> Valley	19. Remarks:		20. Water well contractor's certification: This well was drilled under my jurisdiction and this report is true to the best of my knowledge and belief. Darling Drilling Co. 189 Business name License No. Address 211 W. 4th Hutchinson, Ks. Signed Ronald J. Darling Date 5-10-77 Authorized representative		

Forward the white, blue and pink copies to the Department of Health and Environment

Form WWC-5

21-90-3
T
R
Sec
1/4
1/4
CNE