


1 LOCATION OF WATER WELL: County: Rice Fraction: SE 1/4 NW 1/4 NW 1/4 Section Number: 15 Township Number: T 21 S Range Number: R 9W E/W

Distance and direction from nearest town or city street address of well if located within city? 1 1/4 S of Alden, Kansas

2 WATER WELL OWNER: Cris Fair Sterling Drilling Co. Alden Storage #23 RR#, St. Address, Box #: Route 1 Box 129 Board of Agriculture, Division of Water Resources City, State, ZIP Code: Alden, Kansas 67512 Sterling, Ks. 67579 Application Number: 920154

3 LOCATE WELL'S LOCATION WITH AN "X" IN SECTION BOX:

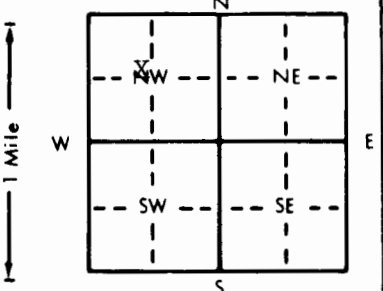

4 DEPTH OF COMPLETED WELL: 49 ft. ELEVATION: Unknown. Depth(s) Groundwater Encountered: 1.12 ft. WELL'S STATIC WATER LEVEL: 12 ft. below land surface measured on mo/day/yr 4/27/92. Pump test data: Well water was 60 gpm. Est. Yield: 60 gpm. Bore Hole Diameter: 8 in. to 49 ft. and in. to ft. WELL WATER TO BE USED AS: 5 Public water supply, 8 Air conditioning, 11 Injection well, 1 Domestic, 3 Feedlot, 6 Oil field water supply, 9 Dewatering, 12 Other (Specify below), 2 Irrigation, 4 Industrial, 7 Lawn and garden only, 10 Monitoring well. Was a chemical/bacteriological sample submitted to Department? Yes No; If yes, mo/day/yr sample was submitted. Water Well Disinfected? Yes No

5 TYPE OF BLANK CASING USED: 1 Steel, 3 RMP (SR), 2 PVC, 4 ABS. 5 Wrought iron, 6 Asbestos-Cement, 7 Fiberglass. 8 Concrete tile, 9 Other (specify below). CASING JOINTS: Glued, Clamped, Welded, Threaded. Blank casing diameter: 5 in. to 29 ft. Dia. Casing height above land surface: 12 in. weight: 2.8 lbs./ft. Wall thickness or gauge No. Sch. 40. TYPE OF SCREEN OR PERFORATION MATERIAL: 1 Steel, 3 Stainless steel, 5 Fiberglass, 7 PVC, 8 RMP (SR), 10 Asbestos-cement, 2 Brass, 4 Galvanized steel, 6 Concrete tile, 9 ABS, 11 Other (specify), 12 None used (open hole). SCREEN OR PERFORATION OPENINGS ARE: 1 Continuous slot, 3 Mill slot, 5 Gauzed wrapped, 8 Saw cut, 11 None (open hole), 2 Louvered shutter, 4 Key punched, 6 Wire wrapped, 9 Drilled holes, 7 Torch cut, 10 Other (specify). SCREEN-PERFORATED INTERVALS: From 29 ft. to 49 ft. GRAVEL PACK INTERVALS: From 20 ft. to 49 ft.

6 GROUT MATERIAL: 1 Neat cement, 2 Cement grout, 3 Bentonite, 4 Other. Grout Intervals: From 0 ft. to 20 ft. What is the nearest source of possible contamination: 1 Septic tank, 4 Lateral lines, 7 Pit privy, 10 Livestock pens, 14 Abandoned water well, 2 Sewer lines, 5 Cess pool, 8 Sewage lagoon, 11 Fuel storage, 15 Oil well/Gas well, 3 Watertight sewer lines, 6 Seepage pit, 9 Feedyard, 12 Fertilizer storage, 16 Other (specify below). Direction from well? South How many feet? 60

Table with columns: FROM, TO, LITHOLOGIC LOG, FROM, TO, PLUGGING INTERVALS. Rows: 0 to 10 (Clay), 10 to 49 (Sand and gravel).

7 CONTRACTOR'S OR LANDOWNER'S CERTIFICATION: This water well was (1) constructed, (2) reconstructed, or (3) plugged under my jurisdiction and was completed on (mo/day/year) 4/27/92 and this record is true to the best of my knowledge and belief. Kansas Water Well Contractor's License No. 186 This Water Well Record was completed on (mo/day/yr) 6/30/92 under the business name of Kelly's Water Well Service, Inc. by (signature)

INSTRUCTIONS: Use typewriter or ball point pen. PLEASE PRESS FIRMLY and PRINT clearly. Please fill in blanks, underline or circle the correct answers. Send top three copies to Kansas Department of Health and Environment, Bureau of Water, Topeka, Kansas 66620-0001. Telephone: 913-296-5545. Send one to WATER WELL OWNER and retain one for your records.