


WATER WELL RECORD Form WWC-5 KSA 82a-1212

1 LOCATION OF WATER WELL: County: Rice Fraction SE 1/4 SE 1/4 NW 1/4 Section Number 15 Township Number T 21 S Range Number R 9W E/W

Distance and direction from nearest town or city street address of well if located within city? 1 S of Alden, Kansas

2 WATER WELL OWNER: Chris Fair Sterling Drilling Co. Alden Storage #22 RR#, St. Address, Box #: Route 1 Box 129 Board of Agriculture, Division of Water Resources City, State, ZIP Code: Alden, Ks. 67512 Sterling, Ks. 67579 Application Number:

3 LOCATE WELL'S LOCATION WITH AN "X" IN SECTION BOX: 4 DEPTH OF COMPLETED WELL: 45 ft. ELEVATION:

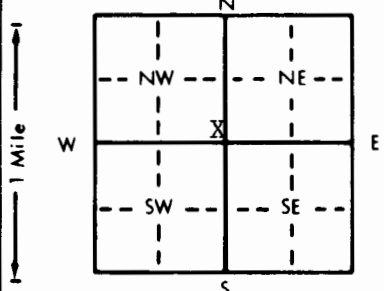

Depth(s) Groundwater Encountered 1... ft. 2... ft. 3... ft. WELL'S STATIC WATER LEVEL 40 below land surface measured on mo/day/yr 12/21/92 Pump test data: Well water was... ft. after... hours pumping... gpm Est. Yield... gpm: Well water was... ft. after... hours pumping... gpm Bore Hole Diameter... in. to... ft. and... in. to... ft. WELL WATER USED AS: 5 Public water supply 8 Air conditioning 11 Injection well 1 Domestic WAS 3 Feedlot 6 Oil field water supply 9 Dewatering 12 Other (Specify below) 2 Irrigation 4 Industrial 7 Lawn and garden only 10 Monitoring well Was a chemical/bacteriological sample submitted to Department? Yes... No X; If yes, mo/day/yr sample was submitted Water Well Disinfected? Yes... No X

5 TYPE OF BLANK CASING USED: 1 Steel 3 RMP (SR) 5 Wrought iron 8 Concrete tile CASING JOINTS: Glued... Clamped... 2 PVC 4 ABS 6 Asbestos-Cement 9 Other (specify below) Welded... Threaded...

Blank casing diameter 5 in. to... ft. Dia... in. to... ft. Dia... in. to... ft. Casing height above land surface 3 ft. below in. weight... lbs./ft. Wall thickness or gauge No.

TYPE OF SCREEN OR PERFORATION MATERIAL: 1 Steel 3 Stainless steel 5 Fiberglass 8 RMP (SR) 11 Other (specify) NA 2 Brass 4 Galvanized steel 6 Concrete tile 9 ABS 12 None used (open hole)

SCREEN OR PERFORATION OPENINGS ARE: 1 Continuous slot 3 Mill slot 5 Gauzed wrapped 8 Saw cut 11 None (open hole) 2 Louvered shutter 4 Key punched 6 Wire wrapped 9 Drilled holes 7 Torch cut 10 Other (specify) NA

SCREEN-PERFORATED INTERVALS: From... ft. to... ft. From... ft. to... ft. GRAVEL PACK INTERVALS: From... ft. to... ft. From... ft. to... ft.

6 GROUT MATERIAL: 1 Neat cement 2 Cement grout 3 Bentonite 4 Other Grout Intervals: From... 10 ft. to... 3 ft. From... ft. to... ft. From... ft. to... ft.

What is the nearest source of possible contamination: 1 Septic tank 4 Lateral lines 7 Pit privy 10 Livestock pens 14 Abandoned water well 2 Sewer lines 5 Cess pool 8 Sewage lagoon 11 Fuel storage 15 Oil well/Gas well 3 Watertight sewer lines 6 Seepage pit 9 Feedyard 12 Fertilizer storage 16 Other (specify below) 13 Insecticide storage

Direction from well? How many feet?

Table with columns: FROM, TO, LITHOLOGIC LOG, FROM, TO, PLUGGING INTERVALS. Rows include: 45 to 10 Sand and gravel, 10 to 3 Bentonite, 3 to 0 Top soil.

7 CONTRACTOR'S OR LANDOWNER'S CERTIFICATION: This water well was (1) constructed, (2) reconstructed, or (3) plugged under my jurisdiction and was completed on (mo/day/year) 12/21/92 and this record is true to the best of my knowledge and belief. Kansas Water Well Contractor's License No. 186 This Water Well Record was completed on (mo/day/yr) 3/16/93 under the business name of Kelly's Water Well Service, Inc. by (signature) Sean Sean