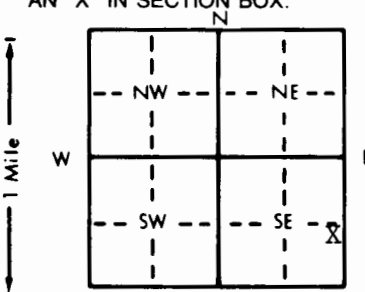


1 LOCATION OF WATER WELL: Fraction NE 1/4 SE 1/4 SE 1/2 NE Section Number 16 Township Number T 21 S Range Number R 9W E/W
 County: Rice
 Distance and direction from nearest town or city street address of well if located within city?

1 1/2 S of Alden, Kansas

2 WATER WELL OWNER: Ed Fair Sterling Drilling Co. Fair #20
 RR#, St. Address, Box #: Route 1 Box 129 Board of Agriculture, Division of Water Resources
 City, State, ZIP Code: Alden, Ks. 67512 Sterling, Kansas 67579 Application Number: 920-199

3 LOCATE WELL'S LOCATION WITH AN "X" IN SECTION BOX:

 4 DEPTH OF COMPLETED WELL: 40 ft. ELEVATION: Unknown
 Depth(s) Groundwater Encountered: 10 ft. 2. ft. 3. ft.
 WELL'S STATIC WATER LEVEL: 10 ft. below land surface measured on mo/day/yr 6/10/92
 Pump test data: Well water was ... ft. after ... hours pumping ... gpm
 Est. Yield: 60 gpm; Well water was ... ft. after ... hours pumping ... gpm
 Bore Hole Diameter: 8 in. to 40 ft., and ... in. to ... ft.
 WELL WATER TO BE USED AS:
 5 Public water supply 8 Air conditioning 11 Injection well
 1 Domestic 3 Feedlot 6 Oil field water supply 9 Dewatering 12 Other (Specify below)
 2 Irrigation 4 Industrial 7 Lawn and garden only 10 Monitoring well
 Was a chemical/bacteriological sample submitted to Department? Yes () No () If yes, mo/day/yr sample was submitted
 Water Well Disinfected? Yes () No ()

5 TYPE OF BLANK CASING USED:
 1 Steel 3 RMP (SR) 5 Wrought iron 8 Concrete tile CASING JOINTS: Glued () Clamped ()
 2 PVC 4 ABS 6 Asbestos-Cement 9 Other (specify below) Welded ()
 7 Fiberglass Threaded ()
 Blank casing diameter: 5 in. to 20 ft., Dia 12 in. to 2.8 in. to ... ft., Dia ... in. to Sch. 40
 Casing height above land surface: ... in., weight ... lbs./ft. Wall thickness or gauge No.
 TYPE OF SCREEN OR PERFORATION MATERIAL:
 1 Steel 3 Stainless steel 5 Fiberglass 8 RMP (SR) 10 Asbestos-cement 11 Other (specify) ...
 2 Brass 4 Galvanized steel 6 Concrete tile 9 ABS 12 None used (open hole)
 SCREEN OR PERFORATION OPENINGS ARE:
 1 Continuous slot 3 Mill slot 5 Gauzed wrapped 8 Saw cut 11 None (open hole)
 2 Louvered shutter 4 Key punched 6 Wire wrapped 9 Drilled holes
 7 Torch cut 10 Other (specify) ...
 SCREEN-PERFORATED INTERVALS: From 20 ft. to 40 ft., From ... ft. to ... ft.
 GRAVEL PACK INTERVALS: From 20 ft. to 40 ft., From ... ft. to ... ft.

6 GROUT MATERIAL: 1 Neat cement 2 Cement grout 3 Bentonite 4 Other
 Grout Intervals: From 0 ft. to 20 ft., From ... ft. to ... ft., From ... ft. to ... ft.
 What is the nearest source of possible contamination:
 1 Septic tank 4 Lateral lines 7 Pit privy 10 Livestock pens 14 Abandoned water well
 2 Sewer lines 5 Cess pool 8 Sewage lagoon 11 Fuel storage 15 Oil well/Gas well
 3 Watertight sewer lines 6 Seepage pit 9 Feedyard 12 Fertilizer storage 16 Other (specify below)
 13 Insecticide storage
 Direction from well? South How many feet? 60

FROM	TO	LITHOLOGIC LOG	FROM	TO	PLUGGING INTERVALS
0	10	Sandy clay			
10	40	Sand and gravel			

7 CONTRACTOR'S OR LANDOWNER'S CERTIFICATION: This water well was (1) constructed, (2) reconstructed, or (3) plugged under my jurisdiction and was completed on (mo/day/year) 6/10/92 and this record is true to the best of my knowledge and belief. Kansas Water Well Contractor's License No. 186 This Water Well Record was completed on (mo/day/yr) 6/30/92 under the business name of Kelly's Water Well Service by (signature) *Sevyn Sead*