


1 LOCATION OF WATER WELL:	Fraction	Section Number	Township Number	Range Number
County: Rice	s $\frac{1}{2}$ $\frac{1}{4}$ n $\frac{1}{2}$ $\frac{1}{4}$ ne $\frac{1}{4}$	31	T 21 S	R 9 W

Distance and direction from nearest town or city street address of well if located within city?

7 west 1 $\frac{1}{4}$ south of Sterling, Ks.

2 WATER WELL OWNER:	White & Ellis Drilling		
RR#, St. Address, Box # :	5532 West 10		Board of Agriculture, Division of Water Resources
City, State, ZIP Code :	Great Bend, Ks.	67530	Application Number: xxxT89-082

3 LOCATE WELL'S LOCATION WITH AN "X" IN SECTION BOX:

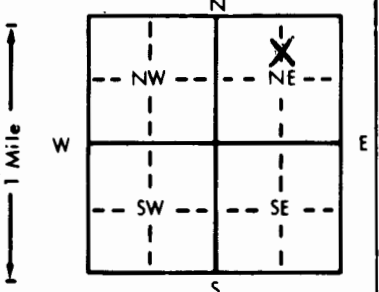

4 DEPTH OF COMPLETED WELL: 60 ft.	ELEVATION:
Depth(s) Groundwater Encountered 1. ft. 2. ft. 3. ft.	
WELL'S STATIC WATER LEVEL 17 ft. below land surface measured on mo/day/yr 3-6-89	
Pump test data: Well water was ft. after hours pumping gpm	
Est. Yield .NA gpm: Well water was ft. after hours pumping gpm	
Bore Hole Diameter 10 in. to 60 ft., and in. to ft.	
WELL WATER TO BE USED AS:	5 Public water supply 8 Air conditioning 11 Injection well
1 Domestic 3 Feedlot <u>6 Oil field water supply</u> 9 Dewatering 12 Other (Specify below)	
2 Irrigation 4 Industrial 7 Lawn and garden only 10 Monitoring well	
Was a chemical/bacteriological sample submitted to Department? Yes No <u>X</u> ; If yes, mo/day/yr sample was sub-	
mitted	Water Well Disinfected? Yes <u>hth</u> No

5 TYPE OF BLANK CASING USED:	5 Wrought iron	8 Concrete tile	CASING JOINTS: Glued <u>X</u> Clamped
1 Steel 3 RMP (SR)	6 Asbestos-Cement	9 Other (specify below)	Welded
2 PVC 4 ABS	7 Fiberglass		Threaded
Blank casing diameter 5 in. to 40 ft., Dia in. to ft., Dia in. to ft.			
Casing height above land surface 18 in., weight 258 lbs./ft. Wall thickness or gauge No.			
TYPE OF SCREEN OR PERFORATION MATERIAL:	7 PVC	10 Asbestos-cement	
1 Steel 3 Stainless steel 5 Fiberglass	8 RMP (SR)	11 Other (specify)	
2 Brass 4 Galvanized steel 6 Concrete tile	9 ABS	12 None used (open hole)	
SCREEN OR PERFORATION OPENINGS ARE:	5 Gauzed wrapped	8 Saw cut	11 None (open hole)
1 Continuous slot 3 Mill slot	6 Wire wrapped	9 Drilled holes	
2 Louvered shutter 4 Key punched	7 Torch cut	10 Other (specify)	
SCREEN-PERFORATED INTERVALS: From 40 ft. to 60 ft., From ft. to ft.			
GRAVEL PACK INTERVALS: From 20 ft. to 60 ft., From ft. to ft.			

6 GROUT MATERIAL:	1 Neat cement	2 <u>Cement grout</u>	3 Bentonite 4 Other
Grout Intervals: From 0 ft. to 20 ft., From ft. to ft.			
What is the nearest source of possible contamination:	10 Livestock pens	14 Abandoned water well	
1 Septic tank 4 Lateral lines 7 Pit privy	11 Fuel storage	<u>15 Oil well/Gas well</u>	
2 Sewer lines 5 Cess pool 8 Sewage lagoon	12 Fertilizer storage	16 Other (specify below)	
3 Watertight sewer lines 6 Seepage pit 9 Feedyard	13 Insecticide storage		
Direction from well? 100 ft south west of oil well	How many feet?		

FROM	TO	LITHOLOGIC LOG	FROM	TO	PLUGGING INTERVALS
0	3	Sandy top soil			
3	15	Brown clay			
15	62	Sand and gravel			

7 CONTRACTOR'S OR LANDOWNER'S CERTIFICATION: This water well was (1) constructed, (2) reconstructed, or (3) plugged under my jurisdiction and was completed on (mo/day/year) 3-6-89 and this record is true to the best of my knowledge and belief. Kansas Water Well Contractor's License No. 134 This Water Well Record was completed on (mo/day/yr) 3-17-89 under the business name of Rosencrantz-Bemis by (signature) Media Hedson

INSTRUCTIONS: Use typewriter or ball point pen. PLEASE PRESS FIRMLY and PRINT clearly. Please fill in blanks, underline or circle the correct answers. Send top three copies to Kansas Department of Health and Environment, Bureau of Water Protection, Topeka, Kansas 66620-7320. Telephone: 913-296-5514. Send one to WATER WELL OWNER and retain one for your records.