WELL #3 OF 4 WELL MANIFOLD SYSTEM

WATER WELL RECORD Form WWC-5 KSA 82a-1212

1 LOCATION OF WATER WELL: County: Rice | Fraction: SW ¼ NW ¼ NE ¼ | Section Number: 35 | Township Number: T 21 S | Range Number: R ~~E~~ 9 ~~E~~/W

Distance and direction from nearest town or city street address of well if located within city?
Approx. 3½ miles west and 1¼ mi. south of Sterling

2 WATER WELL OWNER: Duane Johnson
RR#, St. Address, Box # : Rural Route
City, State, ZIP Code : Sterling, KS 67579

Board of Agriculture, Division of Water Resources Application Number: 37348

3 LOCATE WELL'S LOCATION WITH AN "X" IN SECTION BOX:

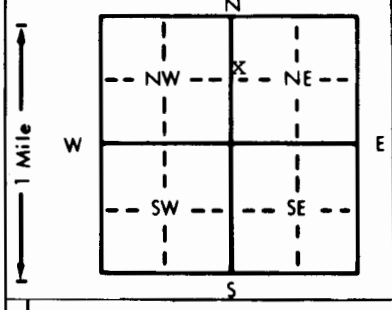

4 DEPTH OF COMPLETED WELL 51'6" ft. ELEVATION: unknown
Depth(s) Groundwater Encountered 1. 10 ft. 2. ft. 3. ft.
WELL'S STATIC WATER LEVEL 10 ft. below land surface measured on mo/day/yr 5-16-85
Pump test data: Well water was not ckd' ft. after hours pumping gpm
Est. Yield 200 gpm: Well water was ft. after hours pumping gpm
Bore Hole Diameter 18 in. to 51'6" ft., and in. to ft.
WELL WATER TO BE USED AS: 1 Domestic 2 Irrigation 3 Feedlot 4 Industrial 5 Public water supply 6 Oil field water supply 7 Lawn and garden only 8 Air conditioning 9 Dewatering 10 Observation well 11 Injection well 12 Other (Specify below)
Was a chemical/bacteriological sample submitted to Department? Yes ..... No X ; If yes, mo/day/yr sample was submitted
Water Well Disinfected? Yes ~~XX~~ No X

5 TYPE OF BLANK CASING USED: ~~XX~~ 2 PVC | 3 RMP (SR) | 4 ABS | 5 Wrought iron | 6 Asbestos-Cement | 7 Fiberglass | 8 Concrete tile | 9 Other (specify below)
CASING JOINTS: Glued XX Clamped ~~XX~~ Welded ~~XXXXXXXX~~ Threaded
Blank casing diameter 8 in. to 38 ft., Dia in. to ft., Dia in. to ft.
Casing height above land surface 18 in., weight 6.679 lbs./ft. Wall thickness or gauge No. .410
TYPE OF SCREEN OR PERFORATION MATERIAL: 1 Steel | 2 Brass | 3 Stainless steel | 4 Galvanized steel | 5 Fiberglass | 6 Concrete tile | 7 PVC | 8 RMP (SR) | 9 ABS | 10 Asbestos-cement | 11 Other (specify) | 12 None used (open hole)
SCREEN OR PERFORATION OPENINGS ARE: 1 Continuous slot | 2 Louvered shutter | 3 Mill slot | 4 Key punched | 5 Gauzed wrapped | 6 Wire wrapped | 7 Torch cut | 8 Saw cut | 9 Drilled holes | 10 Other (specify) Doerr Bridge Slot | 11 None (open hole)
SCREEN-PERFORATED INTERVALS: From 38 ft. to 50 ft., From ft. to ft.
From ft. to ft., From ft. to ft.
GRAVEL PACK INTERVALS: From 10 ft. to 51'6" ft., From ft. to ft.
From ft. to ft., From ft. to ft.

6 GROUT MATERIAL: 1 Neat cement | 2 Cement grout | 3 Bentonite | 4 Other
Grout Intervals: From 0 ft. to 10 ft., From ~~XXX~~ ft. to ft., From ft. to ft.
What is the nearest source of possible contamination: 1 Septic tank | 2 Sewer lines | 3 Watertight sewer lines | 4 Lateral lines | 5 Cess pool | 6 Seepage pit | 7 Pit privy | 8 Sewage lagoon | 9 Feedyard | 10 Livestock pens | 11 Fuel storage | 12 Fertilizer storage | 13 Insecticide storage | 14 Abandoned water well | 15 Oil well/Gas well | 16 Other (specify below) FIELD
Direction from well? all How many feet?

FROM	TO	LITHOLOGIC LOG	FROM	TO	LITHOLOGIC LOG
0	10	Topsoil, & brown clay			
10	29	Sand & gravel, med. to fine to coarse			
29	37	Green & brown clay			
37	50	Sand & gravel, fine to very fine to med. clean			
50	51'6"	Brown clay			

7 CONTRACTOR'S OR LANDOWNER'S CERTIFICATION: This water well was (1) constructed, (2) reconstructed, or (3) plugged under my jurisdiction and was completed on (mo/day/year) 5/16/85 and this record is true to the best of my knowledge and belief. Kansas Water Well Contractor's License No. 185 This Water Well Record was completed on (mo/day/yr) 6/12/85 under the business name of Clarke Well & Eq., Inc. by (signature)

INSTRUCTIONS: Use typewriter or ball point pen, *PLEASE PRESS FIRMLY* and *PRINT* clearly. Please fill in blanks, underline or circle the correct answers. Send top three copies to Kansas Department of Health and Environment, Division of Environment, Environmental Geology Section, Topeka, KS 66620. Send one to WATER WELL OWNER and retain one for your records.