


1 LOCATION OF WATER WELL: County: Rice	Fraction SW ¼ NW ¼ NE ¼	Section Number 35	Township Number T 21 S	Range Number R 9 X W
---	----------------------------	----------------------	---------------------------	---------------------------------------

Distance and direction from nearest town or city street address of well if located within city?
 Approx. 3½ west and 1¼ south of Sterling

2 WATER WELL OWNER: Duane Johnson
 RR#, St. Address, Box #: Rural Route
 City, State, ZIP Code: Sterling, KS 67579
 Board of Agriculture, Division of Water Resources
 Application Number: 37348

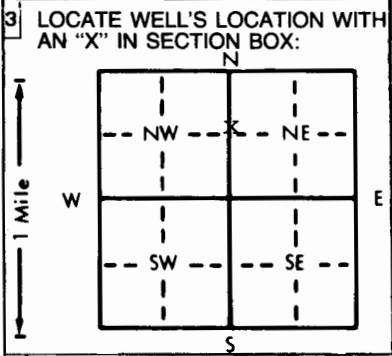

4 DEPTH OF COMPLETED WELL: 52 ft. ELEVATION: unknown
 Depth(s) Groundwater Encountered 1. 10 ft. 2. . ft. 3. . ft.
 WELL'S STATIC WATER LEVEL: 10 ft. below land surface measured on mo/day/yr 5-17-85
 Pump test data: Well water was not ck'd ft. after . hours pumping . gpm
 Est. Yield: 200 gpm; Well water was . ft. after . hours pumping . gpm
 Bore Hole Diameter: 18 in. to 52 ft., and . in. to . ft.
 WELL WATER TO BE USED AS:
 5 Public water supply 8 Air conditioning 11 Injection well
 1 Domestic 3 Feedlot 6 Oil field water supply 9 Dewatering 12 Other (Specify below)
 2 Irrigation 4 Industrial 7 Lawn and garden only 10 Observation well
 Was a chemical/bacteriological sample submitted to Department? Yes.....No. ; If yes, mo/day/yr sample was submitted
 Water Well Disinfected? Yes No

5 TYPE OF BLANK CASING USED:
 1 Steel 3 RMP (SR) 5 Wrought iron 8 Concrete tile CASING JOINTS: Glued Clamped
 2 PVC 4 ABS 6 Asbestos-Cement 9 Other (specify below) ~~Welded~~
 7 Fiberglass Threaded
 Blank casing diameter: 8 in. to 40 ft., Dia. in. to . ft., Dia. in. to . ft.
 Casing height above land surface: 18 in., weight 6.679 lbs./ft. Wall thickness or gauge No. 410
 TYPE OF SCREEN OR PERFORATION MATERIAL:
 1 Steel 3 Stainless steel 5 Fiberglass 7 PVC 10 Asbestos-cement
 2 Brass 4 Galvanized steel 6 Concrete tile 8 RMP (SR) 11 Other (specify)
 9 ABS 12 None used (open hole)
 SCREEN OR PERFORATION OPENINGS ARE:
 1 Continuous slot 3 Mill slot 5 Gauzed wrapped 8 Saw cut 11 None (open hole)
 2 Louvered shutter 4 Key punched 6 Wire wrapped 9 Drilled holes
 7 Torch cut 10 Other (specify) Doerr Bridge Slot
 SCREEN-PERFORATED INTERVALS: From 40 ft. to 52 ft., From . ft. to . ft.
 GRAVEL PACK INTERVALS: From 10 ft. to 52 ft., From . ft. to . ft.

6 GROUT MATERIAL: 1 Neat cement 2 Cement grout 3 Bentonite 4 Other
 Grout Intervals: From 0 ft. to 10 ft., From . ft. to . ft.
 What is the nearest source of possible contamination:
 1 Septic tank 4 Lateral lines 7 Pit privy 10 Livestock pens 14 Abandoned water well
 2 Sewer lines 5 Cess pool 8 Sewage lagoon 11 Fuel storage 15 Oil well/Gas well
 3 Watertight sewer lines 6 Seepage pit 9 Feedyard 12 Fertilizer storage 16 Other (specify below)
 Field
 Direction from well? all How many feet?

FROM	TO	LITHOLOGIC LOG	FROM	TO	LITHOLOGIC LOG
0	10	Topsoil & brown & gray clay			
10	29	Sand & gravel, med. to fine to coarse			
29	40	Tan & white clay			
40	50'6"	Sand & gravel, fine some med.			
XXXX					
50'6"	52	Brown clay			

7 CONTRACTOR'S OR LANDOWNER'S CERTIFICATION: This water well was (1) constructed, (2) reconstructed, or (3) plugged under my jurisdiction and was completed on (mo/day/year) 5/17/85 and this record is true to the best of my knowledge and belief. Kansas Water Well Contractor's License No. 185 This Water Well Record was completed on (mo/day/yr) 6/12/85 under the business name of Clarke Well & Eq., Inc. by (signature) [Signature]

INSTRUCTIONS: Use typewriter or ball point pen, PLEASE PRESS FIRMLY and PRINT clearly. Please fill in blanks, underline or circle the correct answers. Send top three copies to Kansas Department of Health and Environment, Division of Environment, Environmental Geology Section, Topeka, KS 66620. Send one to WATER WELL OWNER and retain one for your records.