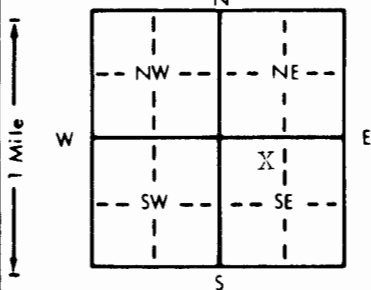


1 LOCATION OF WATER WELL: Fraction NE 1/4 NW 1/4 SE 1/4 Section Number 9 Township Number T 21 S S Range Number R 9 W EW

Distance and direction from nearest town or city street address of well if located within city?  
 304 N. Pioneer, Alden, Kansas

2 WATER WELL OWNER: Larry, Booker  
 RR#, St. Address, Box #: 304 N. Pioneer  
 City, State, ZIP Code: Alden, Kansas 67512  
 Board of Agriculture, Division of Water Resources  
 Application Number:

3 LOCATE WELL'S LOCATION WITH AN "X" IN SECTION BOX:  4 DEPTH OF COMPLETED WELL: 60 ft. ELEVATION:  
 Depth(s) Groundwater Encountered: 1 ft. 2 ft. 3 ft.  
 WELL'S STATIC WATER LEVEL: 15 ft. below land surface measured on mo/day/yr  
 Pump test data: Well water was \_\_\_\_\_ ft. after \_\_\_\_\_ hours pumping \_\_\_\_\_ gpm  
 Est. Yield \_\_\_\_\_ gpm: Well water was \_\_\_\_\_ ft. after \_\_\_\_\_ hours pumping \_\_\_\_\_ gpm  
 Bore Hole Diameter: 9 in. to \_\_\_\_\_ ft., and \_\_\_\_\_ in. to \_\_\_\_\_ ft.  
 WELL WATER TO BE USED AS:  
 1 Domestic    3 Feedlot    6 Oil field water supply    9 Dewatering    12 Other (Specify below)  
 2 Irrigation    4 Industrial    7 Lawn and garden only    10 Monitoring well  
 Was a chemical/bacteriological sample submitted to Department? Yes \_\_\_\_\_ No ; If yes, mo/day/yr sample was sub-  
 mitted \_\_\_\_\_ Water Well Disinfected? Yes  No

5 TYPE OF BLANK CASING USED:  
 1 Steel     2 PVC     3 RMP (SR)     4 ABS     5 Wrought iron     6 Asbestos-Cement     7 Fiberglass     8 Concrete tile     9 Other (specify below)  
 Blank casing diameter: 5 in. to 40 ft., Dia \_\_\_\_\_ in. to \_\_\_\_\_ ft., Dia \_\_\_\_\_ in. to \_\_\_\_\_ ft.  
 Casing height above land surface: 18 in., weight \_\_\_\_\_ lbs./ft. Wall thickness or gauge No. \_\_\_\_\_  
 TYPE OF SCREEN OR PERFORATION MATERIAL:  
 1 Steel     2 Brass     3 Stainless steel     4 Galvanized steel     5 Fiberglass     6 Concrete tile     7 PVC     8 RMP (SR)     9 ABS     10 Asbestos-cement     11 Other (specify) \_\_\_\_\_  
 12 None used (open hole)  
 SCREEN OR PERFORATION OPENINGS ARE:  
 1 Continuous slot     2 Louvered shutter     3 Mill slot     4 Key punched     5 Gauzed wrapped     6 Wire wrapped     7 Torch cut     8 Saw cut     9 Drilled holes     10 Other (specify) \_\_\_\_\_  
 11 None (open hole)  
 SCREEN-PERFORATED INTERVALS: From 60 ft. to 40 ft., From \_\_\_\_\_ ft. to \_\_\_\_\_ ft.  
 GRAVEL PACK INTERVALS: From 60 ft. to 15 ft., From \_\_\_\_\_ ft. to \_\_\_\_\_ ft.

6 GROUT MATERIAL: 1 Neat cement    2 Cement grout    3 Bentonite    4 Other Hole plug  
 Grout Intervals: From 15 ft. to 0 ft., From \_\_\_\_\_ ft. to \_\_\_\_\_ ft., From \_\_\_\_\_ ft. to \_\_\_\_\_ ft.  
 What is the nearest source of possible contamination:  
 1 Septic tank     2 Sewer lines     3 Watertight sewer lines     4 Lateral lines     5 Cess pool     6 Seepage pit     7 Pit privy     8 Sewage lagoon     9 Feedyard     10 Livestock pens     11 Fuel storage     12 Fertilizer storage     13 Insecticide storage     14 Abandoned water well     15 Oil well/Gas well     16 Other (specify below) \_\_\_\_\_  
 Direction from well? North east    How many feet? 100

FROM	TO	LITHOLOGIC LOG	FROM	TO	PLUGGING INTERVALS
0	3	Top soil			
3	11	Brown clay			
11	16	Sand and clay mixed			
16	60	Sand and gravel, clean, coarse, loose			
60	70	Medium - fine sand and gravel			

7 CONTRACTOR'S OR LANDOWNER'S CERTIFICATION: This water well was (1) constructed, (2) reconstructed, or (3) plugged under my jurisdiction and was completed on (mo/day/year) 8-13-94 and this record is true to the best of my knowledge and belief. Kansas Water Well Contractor's License No. 134 This Water Well Record was completed on (mo/day/yr) 8-16-94 under the business name of Rosencrantz-Bemis Ent. Inc. by (signature) Greg Dalton