


1 LOCATION OF WATER WELL:	Fraction	Section Number	Township Number	Range Number
County: <i>Harney</i>	<i>SW 1/4 NE 1/4 NE 1/4</i>	<i>18</i>	T <i>33</i> S	R <i>1</i> <i>EW</i>

Distance and direction from nearest town or city street address of well if located within city?
2 mi. W of Herrston - 8515 Cottonwood Ln


2 WATER WELL OWNER: Greg Raleigh
RR#, St. Address, Box # : 8515 Cottonwood Ln
City, State, ZIP Code : Hesston, KS 67062

Board of Agriculture, Division of Water Resources
Application Number: _____

3 LOCATE WELL'S LOCATION WITH AN "X" IN SECTION BOX: 

4 DEPTH OF COMPLETED WELL: 46 ft. ELEVATION: _____

Depth(s) Groundwater Encountered 1. _____ ft. 2. _____ ft. 3. _____ ft.

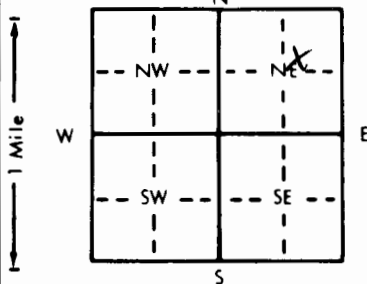

WELL'S STATIC WATER LEVEL ... 13 ... ft. below land surface measured on mo/day/yr ... 9-8-97

Pump test data: Well water was ... 43 ... ft. after ... 1/2 ... hours pumping ... 15 ... gpm

Est. Yield ... 15 ... gpm: Well water was ... ft. after ... hours pumping ... gpm

Bore Hole Diameter ... 8 ... in. to ... 49 ... ft., and ... in. to ... ft.

WELL WATER TO BE USED AS:

5 Public water supply	8 Air conditioning	11 Injection well
1 Domestic	3 Feedlot	6 Oil field water supply
2 Irrigation	4 Industrial	9 Dewatering
	<u>7</u> Lawn and garden only	12 Other (Specify below)
	10 Monitoring well	

Was a chemical/bacteriological sample submitted to Department? Yes No X ; If yes, mo/day/yr sample was submitted

Water Well Disinfected? Yes X No

5	TYPE OF BLANK CASING USED:	5 Wrought iron	8 Concrete tile	CASING JOINTS: Glued <input checked="" type="checkbox"/> . . . Clamped
	1 Steel	6 Asbestos-Cement	9 Other (specify below)	Welded
	2 PVC	7 Fiberglass		Threaded
	3 RMP (SR)			
	4 ABS			

Blank casing diameter 5 in. to 26 ft. Dia in. to ft. Dia in. to ft.
Casing height above land surface 12 in. weight 2.29 lbs./ft. Wall thickness or gauge No. 160

TYPE OF SCREEN OR PERFORATION MATERIAL:

1 Steel	3 Stainless steel	5 Fiberglass	7 PVC	10 Asbestos-cement
2 Brass	4 Galvanized steel	6 Concrete tile	8 RMP (SR)	11 Other (specify)
			9 ABS	12 None used (open hole)

SCREEN OR PERFORATION OPENINGS ARE:

1 Continuous slot	3 Mill slot	5 Gauzed wrapped	8 Saw cut	11 None (open hole)
2 Louvered shutter	4 Key punched	6 Wire wrapped	9 Drilled holes	
		7 Torch cut	10 Other (specify)	

SCREEN-PERFORATED INTERVALS: From 26 ft. to 46 ft., From _____ ft. to _____ ft.
From _____ ft. to _____ ft., From _____ ft. to _____ ft.

GRAVEL PACK INTERVALS: From 22 ft. to 49 ft., From _____ ft. to _____ ft.
From _____ ft. to _____ ft., From _____ ft. to _____ ft.

6 GROUT MATERIAL: 1 Neat cement 2 Cement grout 3 Bentonite 4 Other
Grout Intervals: From 2 ft to 22 ft From ft to ft From ft to ft

What is the nearest source of possible contamination:

1 Septic tank	4 Lateral lines	7 Pit privy	10 Livestock pens	14 Abandoned water well
2 Sewer lines	5 Cess pool	8 Sewage lagoon	11 Fuel storage	15 Oil well/Gas well
3 <u>Watertight sewer lines</u>	6 Seepage pit	9 Feedyard	12 Fertilizer storage	16 Other (specify below)
			13 Insecticide storage	

Direction from well? <i>SE</i>		How many feet? <i>75</i>	
FROM	TO	LITHOLOGIC LOG	PLUGGING INTERVALS

[illegible]

7 CONTRACTOR'S OR LANDOWNER'S CERTIFICATION: This water well was (1) constructed, (2) reconstructed, or (3) plugged under my jurisdiction and was completed on (mo/day/year) 9-8-97 and this record is true to the best of my knowledge and belief. Kansas Water Well Contractor's License No. 447 This Water Well Record was completed on (mo/day/yr) 9-23-97 under the business name of Miller Drilling by (signature) E. Miller