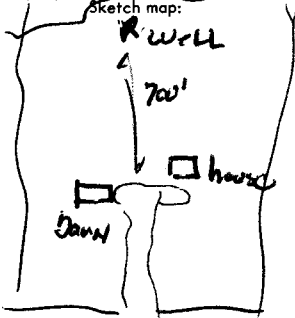


USE TYPEWRITER OR BALL  
POINT PEN-PRESS FIRMLY,  
PRINT CLEARLY.

WATER WELL RECORD  
KSA 82a-1201-1215

Kansas Department of Health and  
Environment-Division of Environment  
(Water well Contractors)  
Topeka, Kansas 66620

1. Location of well:		County <b>HARVEY</b>	Fraction <b>SE 1/4 NW 1/4 SE 1/4</b>	Section number <b>8</b>	Township number T <b>22</b> S R <b>1</b> E <b>W</b>	Range number																																	
2. Distance and direction from nearest town or city: Street address of well location if in city:			<b>1 mile west of Hesston</b> 3. Owner of well: <b>TEL NEUENSCHWANDER</b> R.R. or street: <b>RR #1</b> City, state, zip code: <b>HESSTON, KS 67062</b>																																				
4. Locate with "X" in section below:			Sketch map: 																																				
5. Type and color of material <table border="1" style="width:100%; border-collapse: collapse;"> <thead> <tr> <th></th> <th>From</th> <th>To</th> </tr> </thead> <tbody> <tr><td>LOAM - Silty</td><td>0</td><td>5</td></tr> <tr><td>SANDY BROWN CLAY</td><td>5</td><td>8</td></tr> <tr><td>SAND + CLAY MIX</td><td>8</td><td>10</td></tr> <tr><td>BROWN CLAY</td><td>10</td><td>18</td></tr> <tr><td>SAND - MED SIZE</td><td>18</td><td>28</td></tr> <tr><td>SHALE - green to grey</td><td>28</td><td>34</td></tr> <tr><td>SHALE - Soft red</td><td>34</td><td>36</td></tr> <tr><td>SHALE - grey</td><td>36</td><td>40</td></tr> <tr><td>" " to dark</td><td>40</td><td>45</td></tr> <tr><td>SHALE - dark</td><td>45</td><td>48</td></tr> </tbody> </table>				From	To	LOAM - Silty	0	5	SANDY BROWN CLAY	5	8	SAND + CLAY MIX	8	10	BROWN CLAY	10	18	SAND - MED SIZE	18	28	SHALE - green to grey	28	34	SHALE - Soft red	34	36	SHALE - grey	36	40	" " to dark	40	45	SHALE - dark	45	48	6. Bore hole dia. <b>4 1/4</b> in. Completion date <b>9/9/78</b> Well depth <b>48</b> ft. 7. <input checked="" type="checkbox"/> Cable tool <input checked="" type="checkbox"/> Rotary <input type="checkbox"/> Driven <input type="checkbox"/> Dug <input type="checkbox"/> Hollow rod <input type="checkbox"/> Jetted <input type="checkbox"/> Bored <input type="checkbox"/> Reverse rotary 8. Use: <input checked="" type="checkbox"/> Domestic <input type="checkbox"/> Public supply <input type="checkbox"/> Industry <input type="checkbox"/> Irrigation <input type="checkbox"/> Air conditioning <input type="checkbox"/> Stock <input type="checkbox"/> Lawn <input type="checkbox"/> Oil field water <input type="checkbox"/> Other 9. Casing: Material <b>plastic</b> Height: <b>30</b> in. or below Threaded <input type="checkbox"/> Welded <input checked="" type="checkbox"/> Surface <input type="checkbox"/> in. RMP <input type="checkbox"/> PVC <input checked="" type="checkbox"/> Weight <b>3.62</b> lbs./ft. Dia. <b>6</b> in. to <b>48</b> ft. depth Wall Thickness: inches or Dia. <input type="checkbox"/> in. to <input type="checkbox"/> ft. depth gage No. <b>280</b>			
	From	To																																					
LOAM - Silty	0	5																																					
SANDY BROWN CLAY	5	8																																					
SAND + CLAY MIX	8	10																																					
BROWN CLAY	10	18																																					
SAND - MED SIZE	18	28																																					
SHALE - green to grey	28	34																																					
SHALE - Soft red	34	36																																					
SHALE - grey	36	40																																					
" " to dark	40	45																																					
SHALE - dark	45	48																																					
10. Screen: Manufacturer's name <b>KAM-TECH</b> Type <b>PVC</b> Dia. <b>6 1/4</b> Slot/gauze <b>1020</b> Length <b>10'</b> Set between <b>18</b> ft. and <b>28</b> ft. Gravel pack? <input checked="" type="checkbox"/> Size range of material <b>48-1/4</b>			11. Static water level: <b>12</b> ft. below land surface Date <b>8/21/78</b> 12. Pumping level below land surfaces: <b>22</b> ft. after <b>2</b> hrs. pumping <b>18</b> g.p.m. Estimated maximum yield <b>20</b> g.p.m. 13. Water sample submitted: <b>X</b> Yes <input type="checkbox"/> No Date																																				
14. Well head completion: <input checked="" type="checkbox"/> Pitless adapter <b>30"</b> Inches above grade			15. Well grouted? <input checked="" type="checkbox"/> With: <input checked="" type="checkbox"/> Neat cement <input type="checkbox"/> Bentonite <input type="checkbox"/> Concrete Depth: From <b>10</b> ft. to <b>0</b> ft.																																				
16. Nearest source of possible contamination: ft. <b>55'</b> Direction <b>North</b> Type <b>check</b> Well disinfected upon completion? <input checked="" type="checkbox"/> Yes <input type="checkbox"/> No			17. Pump: Manufacturer's name <b>Dempster</b> Model number <b>DMC-50-32P</b> <b>1/2</b> Volts <b>230</b> Length of drop pipe <b>35</b> ft. capacity <b>12</b> g.p.m. Type: <input checked="" type="checkbox"/> Submersible <input type="checkbox"/> Turbine <input type="checkbox"/> Jet <input type="checkbox"/> Reciprocating <input type="checkbox"/> Centrifugal <input type="checkbox"/> Other																																				
18. Elevation:  Topography: <input type="checkbox"/> Hill <input type="checkbox"/> Slope <input type="checkbox"/> Upland <input type="checkbox"/> Valley			19. Remarks:  <b>OWNER to pour 4' sq. slab ON top when doing other conc. work</b>																																				
20. Water well contractor's certification: This well was drilled under my jurisdiction and this report is true to the best of my knowledge and belief. <b>PAUL'S INC #175</b> Business name License No. Address <b>HESSTON, KS 67062</b> Signed <b>Paul Burdett</b> Date <b>9/14/78</b> Authorized representative																																							

Forward the white, blue and pink copies to the Department of Health and Environment

Form WWC-5

22 - 10 - 8 SE NW SE  
 1/4 1/4 1/4